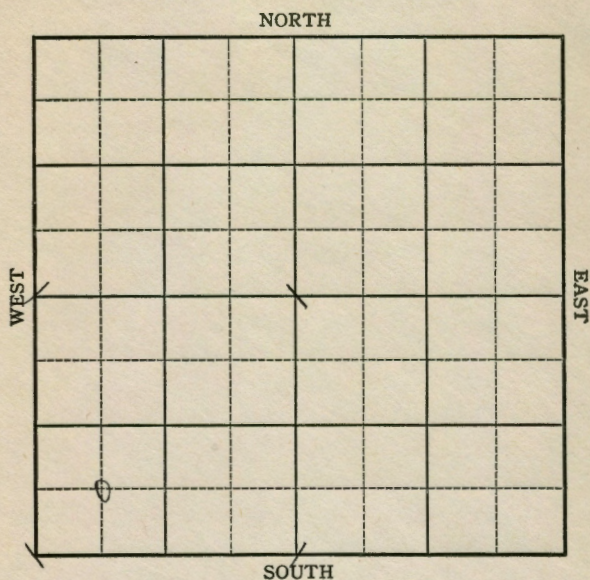


KANSAS

FORM 51 5M 10-41 PETROL

Phillips

Section 20 Township 3 Range 20-WWell No. #1 PerryCompany Northern Ordnance

13

FORM 252-A
5M 9-42 GAS

KANSAS


Phillips

Sec. 20 Twp. 3 R. 20-WWell No. #1 Perry Farm
Northern Ordnance Company

Wildcat

 Ft. from N. Line660 Ft. from S. Line Ft. from E. Line660 Ft. from W. Line

Elev. 2195

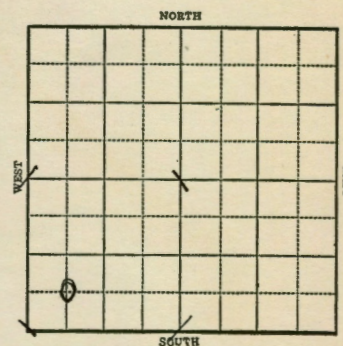

1943

REPORT

3/17 Location Carter Farmout

3/24 "

3/27 10" @ 245 Dakota 945 Anhy 1843 Drlg. 1900

4/14 **Lans 3446**
Arb. 3739
T.D. 3790'
No shows.

ABANDONED

Phillips

KANSAS

Map No. 33 Sec. 20- Twp. 3 R. 20WWell No. 1 Perry

Northern Ordinance


Company

ABANDONED

Contractor

C S W S W

SECTION PLAT

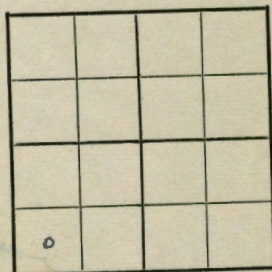

Ft. from N. Line

660 Ft. from S. Line

Ft. from E. Line

660 Ft. from W. Line

WILDCAT

Location

Rig up

Drilling and Remarks:

*Line 3446**At 3339**No hole*

RECORD

Cased in, ft.

Sand

Gas

Oil

Total Depth 3290

PRODUCTION

1st 24 hrs. Nat.

1st 24 hrs. after shot

Gas Cu. Ft.

Dry Hole

Abandoned

Date

APR 14 1943 19S. J. LEWIS Scout

KANSAS

Phillips

Map No. 33 Sec. 20 Twp. 3 R. 20WWell No. 1 Perry

Northern Ordinance


Company

FIRST REPORT

Contractor

C S W S W

SECTION PLAT

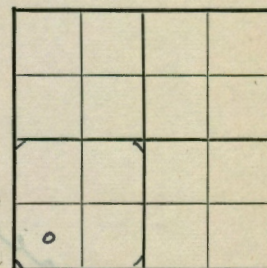

Ft. from N. Line

660 Ft. from S. Line

Ft. from E. Line

660 Ft. from W. Line

WILDCAT

Location XXX

Rig up

Drilling and Remarks:

Carter Farmout

RECORD

Cased in, ft.

Sand

Gas

Oil

Total Depth 2771

PRODUCTION

1st 24 hrs. Nat.

1st 24 hrs. after shot

Gas Cu. Ft.

Dry Hole

Abandoned

Date

MAR 17 1943 19S. J. LEWIS Scout