


KANSAS

Norton

SECTION 15 TOWNSHIP 3 RANGE 21 W

WELL NO. #1 Hays

COMPANY J-S-F & Durbin Bond

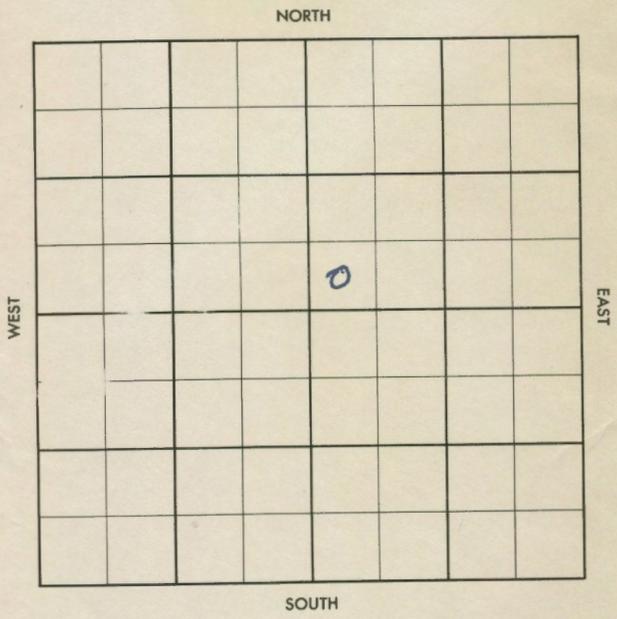

7

NORTON

KANSAS

SEC. 15 TWP. 3 R. 21W

WELL NO. #1 Hays FARM

COMPANY J-S-F & Durbin Bond

CONTRACTOR Co Tools

Wildcat


_____ Ft. from N. Line

_____ Ft. from S. Line

_____ Ft. from E. Line

_____ Ft. from W. Line

SW SW NE

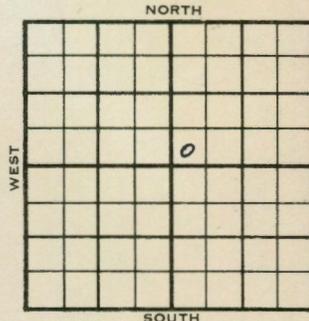

CSO - DHM & FO

1955	ELEVATION	REPORT
	2313 RB	

11/16 Comm 11-11-55
 8" @ 239/120
 Drlg 2508
 Anh 2011

11-23 DST 3743-61 op 1 hr. rec 5' mud, 0/35"
 D & A
 Tops: H. 3546
 Tr. 3571
 L. 3587
 BKC 3777
 A 3850
 TD 3868'

ABANDONED

