



Norton **KANSAS**  
 SECTION 26 TOWNSHIP 3 RANGE 21 W  
 WELL NO. #1 Reeser  
 COMPANY J\*S-F & Durbin Bond

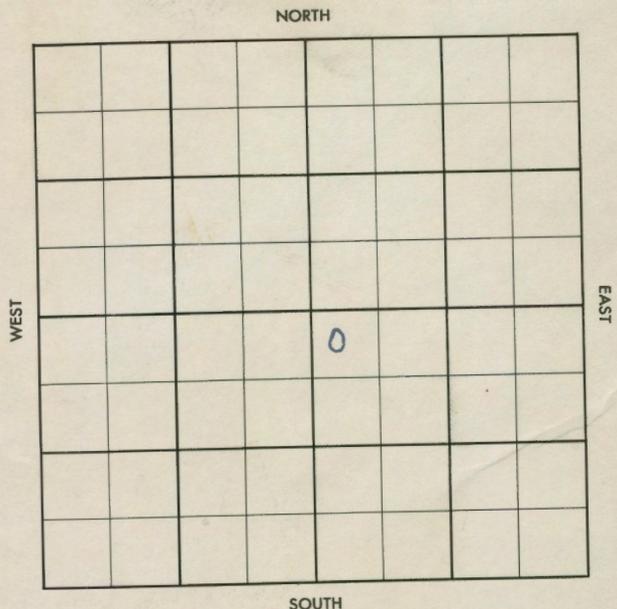

10

NORTON **KANSAS**  
 SEC. 26 TWP. 3 R. 21W  
 WELL NO. #1 Reeser FARM  
 COMPANY J-S-F & Durbin Bond  
 CONTRACTOR Co. tools

**WILDCAT**  
 \_\_\_\_\_ Ft. from N. Line  
 \_\_\_\_\_ Ft. from S. Line  
 \_\_\_\_\_ Ft. from E. Line  
 \_\_\_\_\_ Ft. from W. Line

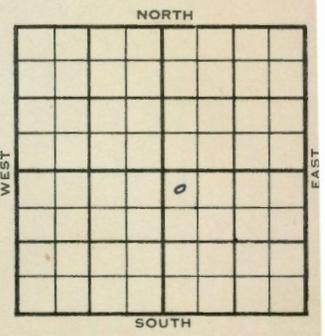

NW NW SE

CSO\* DHM & FO

	ELEVATION	REPORT
1955	2318'	
11-23	MIR	
12-7	Comm. 11-21-55 8 5/8" @ 225/ 125 D & A	
	<u>Tops</u>	<u>Depth</u> <u>Log</u>
	Anh.	1985
	H.	3544
	Tr.	3570
	L.	3589
	BKC	3780
	A	3860
	TD 3895'	
		<b>ABANDONED</b>

DX-78

County Norton Elev. 2318  
 Sec. 26 Twp. 3 Rge. 21W  
 Company J-S-F & Durbin Bond  
 FarmName Reeser No. 1

TOPS	DEPTH	LOG	DATUM	Loc. in Sec.
Anh.	<u>1985</u>			NW NW SE
Tr.				
H.		<u>3544</u>	<u>1226</u>	
Tr.		<u>3570</u>	<u>1252</u>	
Dg.				Geol.
Bl.		<u>3589</u>	<u>1271</u>	
L.				Contr.
K.C.	<u>3780</u>		<u>1462</u>	
B.K.C.				Co. tools
Ce.				
C.				Pool
M.				
M.				Wildcat
K.				
Mz.				<div style="border: 1px dashed black; padding: 5px; text-align: center;"> <b>ABANDONED</b>                  0                  DEC 7 1955             </div>
Me.				
V.				<div style="border: 1px dashed black; padding: 5px; text-align: center;"> <b>FIRST REPORT</b>                  0                  NOV 23 55             </div>
S.		<u>3860</u>	<u>1542</u>	
TD.	<u>3895</u>			

Date Comm. 11-21-55  
8 5/8" @ 225/125

D & A

Co. Lse. No. Sec. T. R.

County Norton Elev. \_\_\_\_\_  
 Sec. 26 Twp. 3 Rge. 21W  
 Company J-S-F & Durbin Bond  
 FarmName Reeser No. 1

TOPS	DEPTH	LOG	DATUM	Loc. in Sec.
Anh.				NW NW SE
Tr.				
H.				
Tr.				
Dg.				Geol.
Bl.				
L.				Contr.
K.C.				
B.K.C.				Co. tools
Ce.				
C.				Pool
M.				
M.				Wildcat
K.				
Mz.				<div style="border: 1px dashed black; padding: 5px; text-align: center;"> <b>FIRST REPORT</b>                  0                  NOV 23 55             </div>
Me.				
TD.				

Date Comm. \_\_\_\_\_  
CSO \* DHM & FO  
MIR

5

Co. Lse. No. Sec. T. R.