


Section 30 Township 3 Range 22W **KANSAS**

Well No. #1 Allen

Company Petroleum Inc.

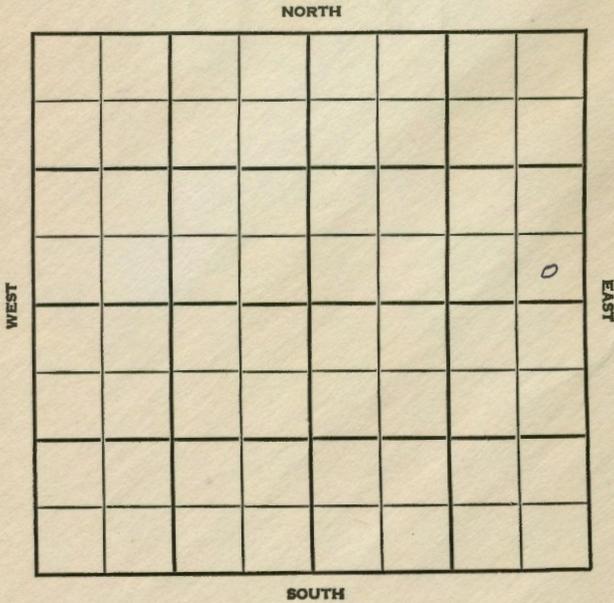


8

NORTON KANSAS

SEC.	30	TWP.	3	R.	22W
WELL NO.	1 Allan			FARM	
COMPANY	Petroleum Inc.				
CONTRACTOR	Garvey Wildcat				

_____ Ft. from N. Line
440 Ft. from S. Line
440 Ft. from E. Line
 _____ Ft. from W. Line

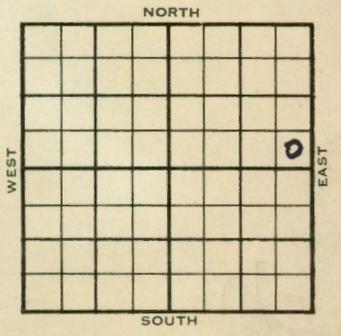

SE SE NE
Sohio-DHM

	ELEVATION	REPORT
1954	2415'	
8-25	Location	
9/8	Spud 8-29-54 D & A TD 3909 8" @ 296 Anhy 1934 Heeb 3535 Lans 3579 TD 3910 DST 3742-3810 open 45 min rec 1325' SW 1000# DST 3818-25 open 1 hr rec 1080' SW 750# Schl tops: Heeb 3533 Tor. 3557 Lans 3572 B KC 3756 Arb. 3814 Gr. wash 3832' Gr. 3894 TD 3909' D & A	
	ABANDONED	

