


Section 30 Township 3 Range 22W

Well No. #1 Allen

Company Petroleum Inc.

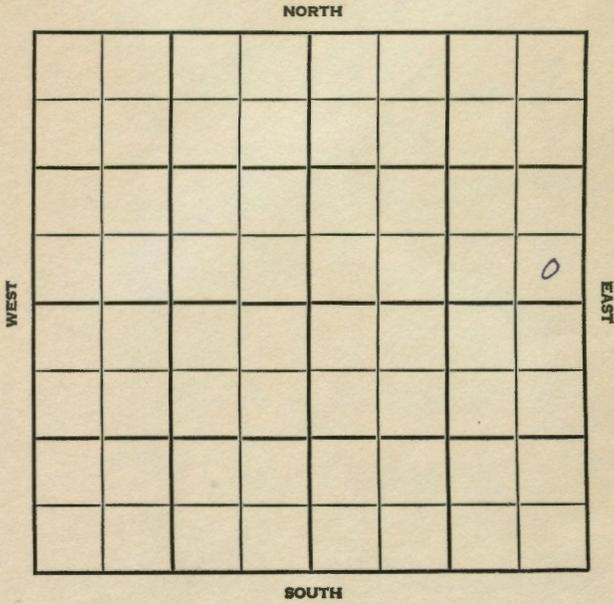

8

SEC.	TWP.	R.
30	3	22 W

WELL NO. # 1 Allen FARM

COMPANY Petroleum Inc.

CONTRACTOR Garvey Wildcat


_____ Ft. from N. Line

330 _____ Ft. from S. Line

330 _____ Ft. from E. Line

_____ Ft. from W. Line

SE SE NE

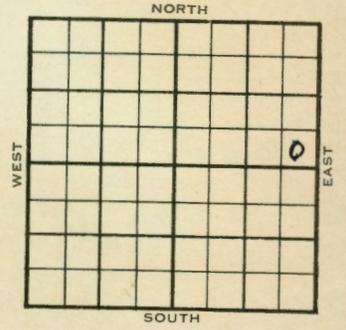

ELEVATION	REPORT
-----------	--------

1954

9/1 Spud 8-29-54
 8" @ 296 Anhy 1934
 Drlg. 2700'

