WELL LOG BUREAU--KANSAS GEOLOGICAL SOCIETY
503 East Murdock, Wichita, Kansas

30-3-23W


Company. D. G. HANSEN
Farm. Webber No. 1

SEC. 30 T. 3 R. 23W
SW SW SW

Total Depth. 3726
Comm. 8-13-53 Comp. 8-20-53
Shot or Treated.
Contractor. C-G Drilling Co.
Issued. 12-19-53

County Norton

KANSAS

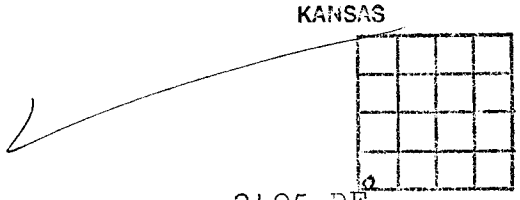

Elevation. 2405 DF

Production. 144 bbls.

CASING:
8 5/8 287.46'
5 1/2 3718.56'

Figures indicate bottom of Formations.

shale & sand	1145
sand	1370
shale & shells	1930
shale	1994
anhydrite	2030
shale	2375
lime & shale	2600
shale & shells	2860
lime & shale	3726
Total Depth	

TOPS:

Heebner	3436
Toronto	3461
Lansing	3476
Base K C	3663
Arbuckle	3718

DST #1: 3719.5-25 open 1 hr. rec. 380'
oil & 75 ' muddy oil, 1180# BHP

DP & DD 1' Swb 6.25 BOPH 800' OB