


Section 31 Township 3 Range 23 W

Well No. # 2 Mindrup

Company Jones, Shelburne & Farmer

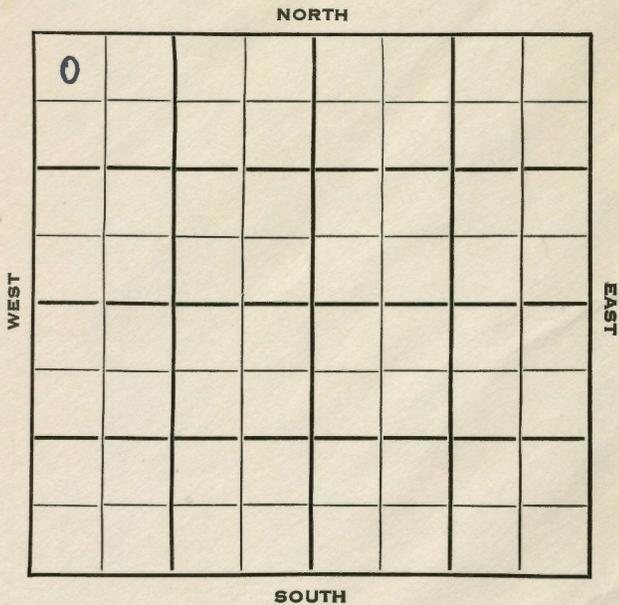

4

Norton KANSAS

SEC. 31	TWP. 3	R. 23W
---------	--------	--------

WELL NO. #2 Mindrup FARM

COMPANY Jones, Shelburne & Farmer

CONTRACTOR


Norton Pool
330 Ft. from N. Line

Ft. from S. Line

Ft. from E. Line

330 Ft. from W. Line

NW NW NW

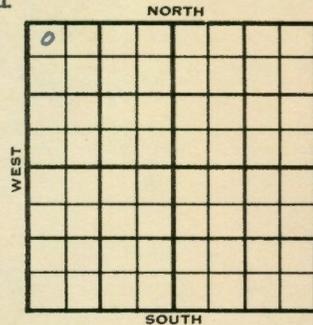

	ELEVATION	REPORT
1953	2411'	
10/21	Location	
10/28	8" @ 280	
	Drlg. 3180'	
11/4	Heeb 3441' Tor. 3466' Lans 3481'	
	B KC 3661' Arb. 3719'	
	RTD 3725' 5" @ 3721	
11/11	CO 3725' 11 BOPH 6 hrs. POP	
11/18	NR	
12/9	NR	
12/16	"	
1954		
1/20	Spud 10-22-53 Oil well TD 3725'	
	8" @ 280 Heeb 3441' Tor 3466'	
	Lans. 3481' B KC 3661' Arb. 3719'	
	TD 3725 5" @ 3721 CO to 3725	
	11 BOPH 6 hr.	
	Comp. 190 BOPD	

COMPLETED

