
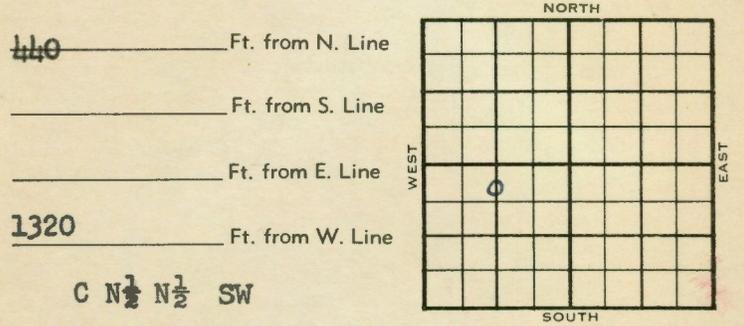


Section 31 Township 3 Range 23 W
 Well No. # 2 Carr-Sneed
 Company Jones, Shelburne & Farmer & CSO

SEC. 31 TWP. 3 R. 23W ✓
 WELL NO. #2 Carr-Sneed FARM
 COMPANY Jones, Shelburne & Farmer & CSO
 CONTRACTOR _____

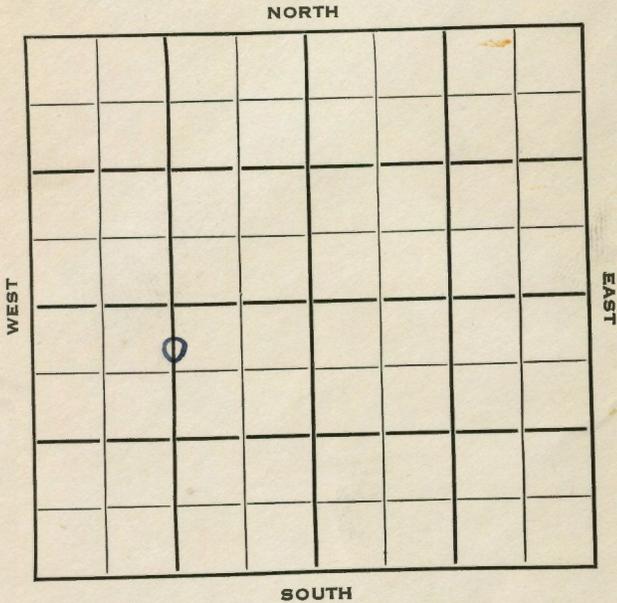

	ELEVATION	REPORT
1953	2411'	
11/18	Spud 11-16-53	
	8" @ 280'	
1954		
2/17	Spud 11-16-53	
	Oil Well	
	TD 3743'	
	8" @ 280'	
	Heeb 3445', Tor 3471', Lans 3485'	
	B KC 3676', Arb 3734',	
	TD 3737'	
	5" @ 3735'	
	DD 3741'	
	B/ 3 goph 500 A	
	DD 3743'	
	S/ 2 1/2 boph 3 hr. 500 A S/ 5 1/2 boph	
	Comp 100 bopd 40% wtr.	

COMPLETED

