


Section 31 Township 3 Range 2 3W

Well No. 1 Carr Sneed "B"

Company Jones, Shelburne & Farmer

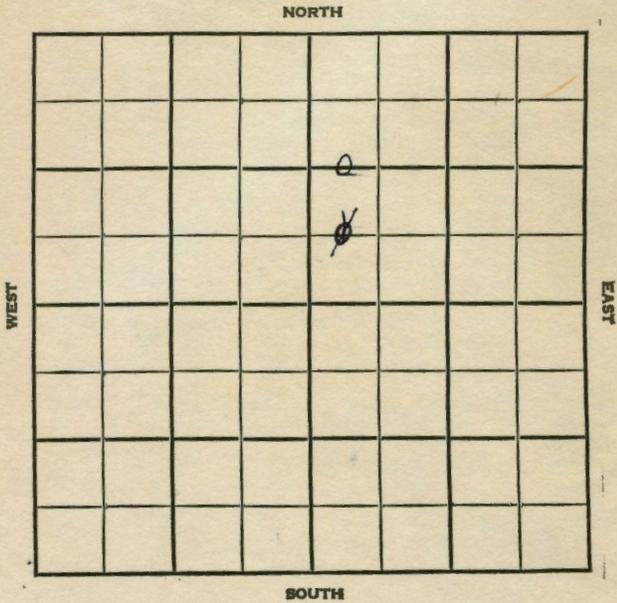

2

SEC. 31 TWP. 3 R. 23 W

COMPANY # 1 Carr Sneed "B" FARM

CONTRACTOR Jones, Shelburne & Farmer

Co. tools

1320 Norton Pool


Ft. from N. Line

Ft. from S. Line

Ft. from E. Line

330 Ft. from W. Line

C W 1/2 W 1/2 NE

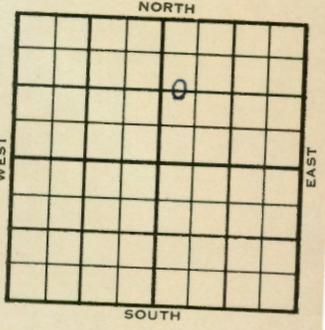

1954	ELEVATION 2359'	REPORT
------	-----------------	--------

10/6 Spud 9-30-54
8" @ 287
Drlg. 2840'

10/20 Spud 9-30-54 - D&A
TD 3719'
8" @ 287'

Anhy 1955', Heeb 3406', Tor 3429',
Lans 3449', Arb. 3688'

DST 3686-89', opn 1/2 hrs., rec. 10'
drlg. mud, 1200#

DST 3689-94', failed

DST 3689-94', opn 1/2 hrs., rec. 15'
OCM, 150#

TD 3694'
5" @ 3690'

CO to 3694' 1/2 go 2 gw 500A 7 gw 1/2 go

DD 3696' 1/2 go 7 gw

DD 3698' 1 go 3 bw

DD 3719'

D&A

ABANDONED

County **Norton** State **Kansas**
 Sec. **31** (Blk. **3** (Sur. **23W** Map No.
 Operator **Jones, Shelburne & Farmer**
 Well No. **1** Farm **Carr Sneed "B"**
 Elev. _____ Location **C W $\frac{1}{2}$ W $\frac{1}{2}$ NE**

1320 Ft. From **N** Line **NE**
330 Ft. From **W** Line **Quarter**
 Ist. Report **OCT 6 1954**
 Completion _____
 Remarks **Co. tools**
 Spudding Date **9-30-54**

Drlg. Data **Norton Pool**
8" @ 287 drlg. 2840

FABEN GILSTRAP

County **Norton** State **Kansas**
 Sec. **31** (Blk. **3** (Sur. **23W** Map No.
 Operator **Jones, Shelburne & Farmer**
 Well No. **1** Farm **Carr Sneed "B"**
 Elev. **2359** Location **C W $\frac{1}{2}$ W $\frac{1}{2}$ NE**

1320 Ft. From **N** Line **NE**
330 Ft. From **W** Line **Quarter**
 Ist. Report _____
 Completion **OCT 20 1954**
 Remarks **Norton Pool**
Co. tools
 Spudding Date **9-30-54**

Drlg. Data **D & A TD 3719**

8" @ 287 Anhy 1955 Heeb. 3406
Tor. 3429 Lans. 3449 Arb. 3688
DST 3686-89 open $\frac{1}{2}$ hr. Rec. 10' drlg.
mud 1200# DST 3689-94 failed
DST 3689-94 open $\frac{1}{2}$ hr. Rec. 15' ocm
150# TD 3694 5" @ 3690 CO to 3694
 $\frac{1}{2}$ go 2 gw 500 A 7 gw $\frac{1}{2}$ go DD 3696
 $\frac{1}{2}$ go 7 gw DD 3698 1 go 3 bw DD 3719
D & A

FABEN GILSTRAP