


Section 31 Township 3 Range 23W

Well No. #3 Mindrup

Company Jones, Shelburne & Farmer

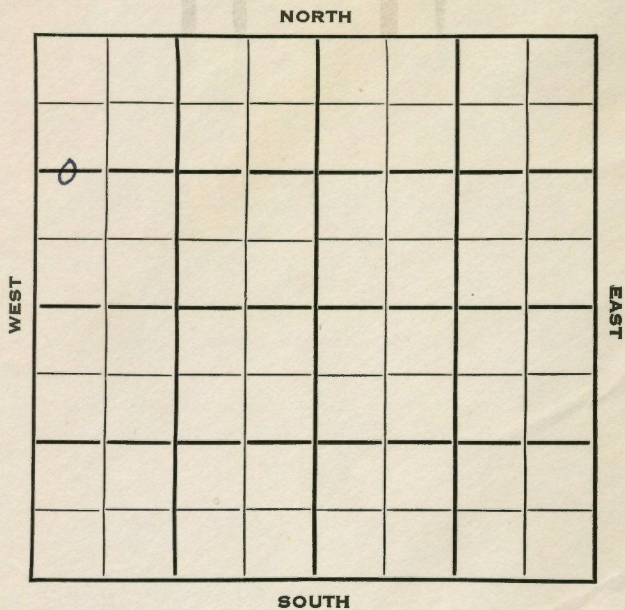

4

SEC. 31 TWP. 3 R. 23W ✓

WELL NO. 3 Mindrup FARM

COMPANY Jones, Shelburne & Farmer


CONTRACTOR J-S-F

1320 Ft. from N. Line

_____ Ft. from S. Line

_____ Ft. from E. Line

440 Ft. from W. Line

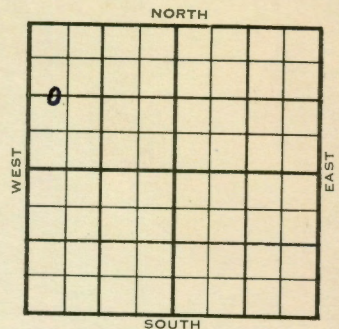

C W/2 W/2 NW

1954 ELEVATION 2379' REPORT

3/10 Spud 3-2-54
 8" @ 280'
 Anhy 1963', Tor 3438'
 B KC 3640', Heeb 3413'
 KC 3453', Arb. 3700'
 TD 3703'
 5" @ 3701', WOCT

3/17 WOCT
 3/24 "
 3/31 DD 3705 S/6 BOPH 10 hrs.

4/21 Spud 3-2-54
 Oil Well
 TD 3709'
 8" @ 280'
 Anhy 1963', Tor 3438', B KC 3640',
 Heeb 3413', KC 3453', Arb. 3700'
 TD 3703'
 5" @ 3701'
 DD 3705'
 S/6 boph 10 hrs.
 DD 3706', S/3½ boph, DD 3707',
 S/3½ boph 500A
 S/3½ boph 2 hrs., DD 3709'
 S/4½ boph 2 hrs.
 Comp. 160 bopd

COMPLETED

