

Section 31 Township 3 Range 23W

Well No. #5 Mindrup

Company Jones, Shelburne & Farmer

SEC. <u>31</u>	TWP. <u>3</u>	R. <u>23W</u>
----------------	---------------	---------------

WELL NO. #5 Mindrup FARM

COMPANY Jones, Shelburne & Farmer

CONTRACTOR J-S-F


Norton Pool

330 Ft. from N. Line


_____ Ft. from S. Line

330 Ft. from E. Line

_____ Ft. from W. Line

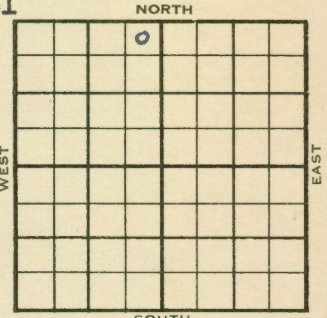

NE NE NW

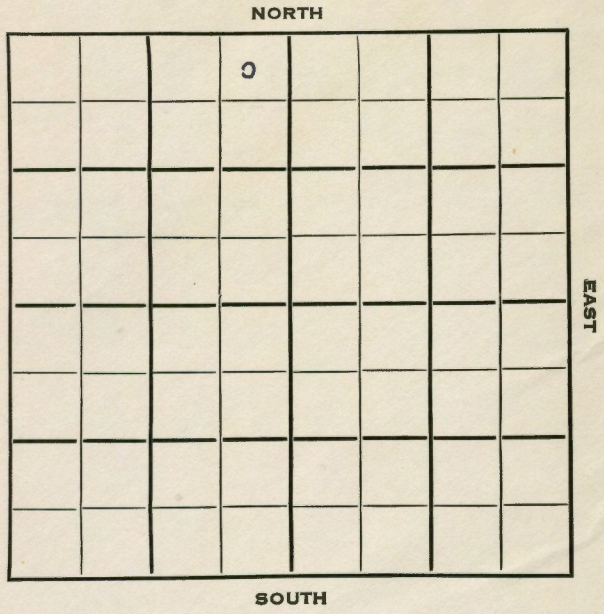

3

1954	ELEVATION <u>2356'</u>	REPORT
------	------------------------	--------

4/7 Spud 4-5-54
8" @ 259'
WOC.

4/14 "

5/5 Spud 4-5-54
Oil Well
TD 3684'
8" @ 259'
Anhy 1945', Heeb 3396', Tor 3418'
Lans 3434', B KC 3616', Arb 3676'
TD 3681'
5" @ 3678'
DD 3684'
1 1/2 boph 1000 A 5 1/2 boph
Comp 170 bopd. **COMPLETED**

