FORM 51

Norton KANSAS

Section 31 Township 3 Range 23 W

Well No. # 6 Mindrup

Company Jones, Shelburne & Farmer

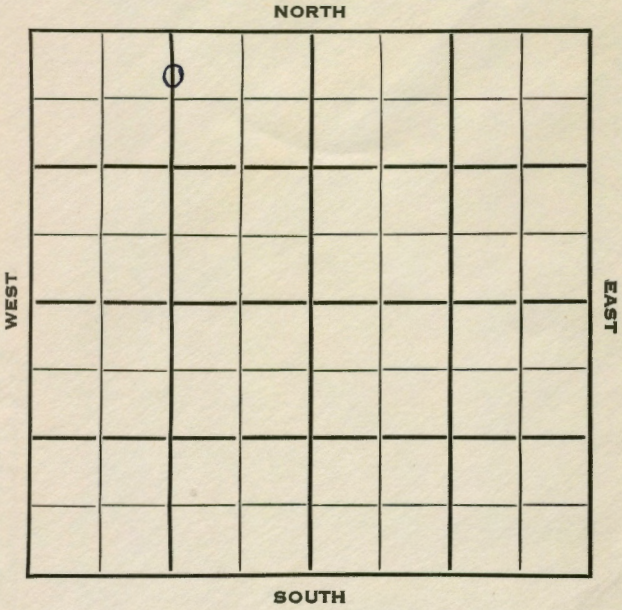

3

Norton KANSAS

SEC.	TWP.	R.
31	3	23 W

WELL NO.

6 Mindrup FARM

COMPANY

Jones, Shelburne & Farmer

CONTRACTOR

J-S-F

Norton Pool

440 Ft. from N. Line

Ft. from S. Line

Ft. from E. Line

1320 Ft. from W. Line

C N½ N½ NW

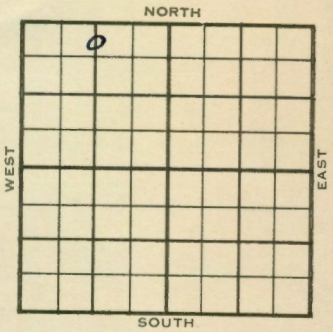

	ELEVATION	REPORT
1954	2380'	
5/12	Spud 5-4-54 8" @ 280 Anhy 1968' Drlg. 3145'	
6/23	Spud 5-4-54 Oil Well TD 3711' 8" @ 280' Anhy 1968', Heeb 3418', Tor 3439', Lans 3459', Arb. 3708' TD 3711' 5" @ 3708' Gorham 3701' CO to 3711 S/4 boph 500A S/6 boph Comp. 183 bopd	

COMPLETED

DX-78

FORM 275 FOR SALE BY KANSAS BLUE PRINT CO.

County Norton State Kansas

Sec. 31 (Blk. Twp.) 3 (Sur. Rge.) 23W Map No.

Operator Jones, Shelburne & Farmer

Well No. 6 Farm Mindrup

Elev. 2380 Location C N½ N½ NW

440 Ft. From N Line NW

1320 Ft. From W Line Quarter

COMPLETE

1st. Report

Completion JUN 23 1954

Remarks Norton Pool

J-S-F - Contr.

Spudding Date 5-4-54

Drlg. Data Oil well TD 3711

8" @ 280 Anhy 1968 Heeb. 3418

Tor. 3439 Lans. 3459 Arb. 3708

TD 3711 5" @ 3708 Gorham 3701

CO to 3711 S/ 4 boph 500 A S/ 6 boph

Comp. 183 bopd

J. G. McGEHEE

FORM 275 FOR SALE BY KANSAS BLUE PRINT CO.

County Norton State Kansas

Sec. 31 (Blk. Twp.) 3 (Sur. Rge.) 23W Map No.

Operator Jones, Shelburne & Farmer

Well No. 6 Farm Mindrup

Elev. 2380 Location C N½ N½ NW

440 Ft. From N Line NW

1320 Ft. From W Line Quarter

FIRST REPORT

1st. Report MAY 12 1954

Completion

Remarks

J-S-F - Contr.

Spudding Date 5-4-54

Drlg. Data Norton Pool

8" @ 280 Anhy 1968 drlg. 3145

J. G. McGEHEE