


Section 31 Township 3 Range 23W
 Well No. 7 Mindrup
 Company Jones Shelburne & Farmer

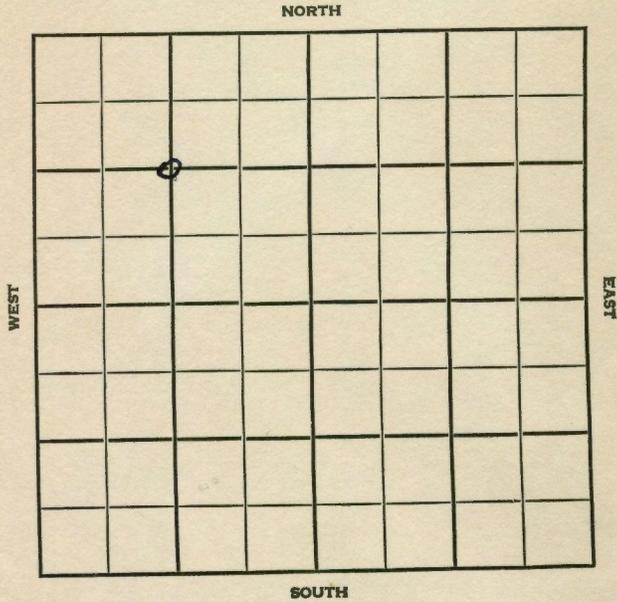

3

NORTON KANSAS


SEC. 31	TWP. 3	R. 23W
---------	--------	--------

WELL NO. 7 Mindrup FARM

COMPANY Jones, Shelburne & Farmer

CONTRACTOR J-S-F

1320 Ft. from N. Line
 _____ Ft. from S. Line
 _____ Ft. from E. Line
1320 Ft. from W. Line

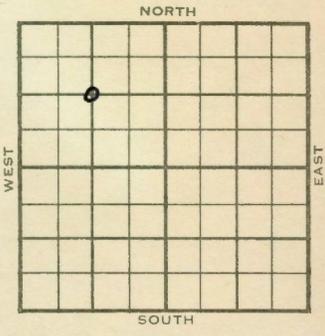

C NW/4

	ELEVATION	REPORT
1954	2360	
6/8	Loc.	
6/23	"	
6/30	8" @ 290'	
	Anhy 1949 1949'	
	Drlg. 2810'	
7/7	Heeb 3398', Lans 3442', Arb. 3681'	
	TD 3685'	
	5" @ 3682'	
8-11	Spdg 6-23-54	
	Oil well	
	TD 3688	
	8" @ 290'	
	Anhy 1949 Heeb 3398 Lans. 3442	
	Arb. 3681	
	TD 3685	
	5" @ 3682 DD 3688 S/ 2 boph 24 hr.	
	2000 A S/ 15 boph 1 hr. S/ 11 bo 3rd	
	hr. Comp. 200 bopd	

COMPLETED

County Norton State Kansas
 Sec. 31 (Blk. 3 (Sur. 23W Map No. 3)
 Operator Jones, Shelburne & Farmer
 Well No. 7 Farm Mindrup
 Elev. 2360 Location C NW/4




1320 Ft. From N Line NW
 1320 Ft. From W Line Quarter
 1st. Report _____
 Completion AUG 11 1954
 Remarks NE Norton Pool
J-S-F - Contr.
 Spudding Date 6-23-54

Drlg. Data Oil well TD 3688
8" @ 290 Anhy 1949 Heeb. 3398
Lans. 3442 Arb. 3681 TD 3685
5" @ 3682 DD 3688 S/ 2 boph 24 hr.
2000 A S/ 15 boph 1 hr. S/ 11 bo 3rd hr
Comp. 200 bopd

72

County Norton State Kansas
 Sec. 31 (Blk. 3 (Sur. 23W Map No. 3)
 Operator Jones, Shelburne & Farmer
 Well No. 7 Farm Mindrup
 Elev. _____ Location C NW/4

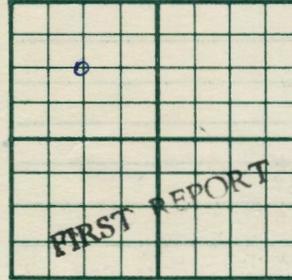

1320 Ft. From N Line NW
 1320 Ft. From W Line Quarter
 1st. Report JUN 9 1954
 Completion _____
 Remarks _____
J-S-F - Contr.
 Spudding Date _____

Drlg. Data _____ NE Norton Pool
Location _____

J. G. McGEHEE