

Section 31 Township 3 Range 23 W

Well No. # 9 Mindrup



Company Jones, Shelburne & Farmer

SEC.	TWP.	R.
31	3	23W

WELL NO. 9 Mindrup FARM

COMPANY Jones, Shelburne & Farmer

CONTRACTOR Co. Tools

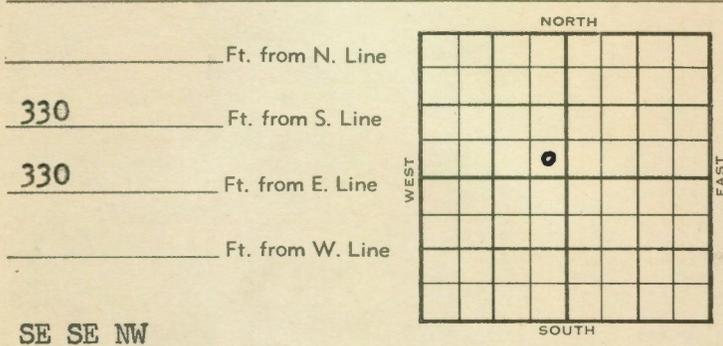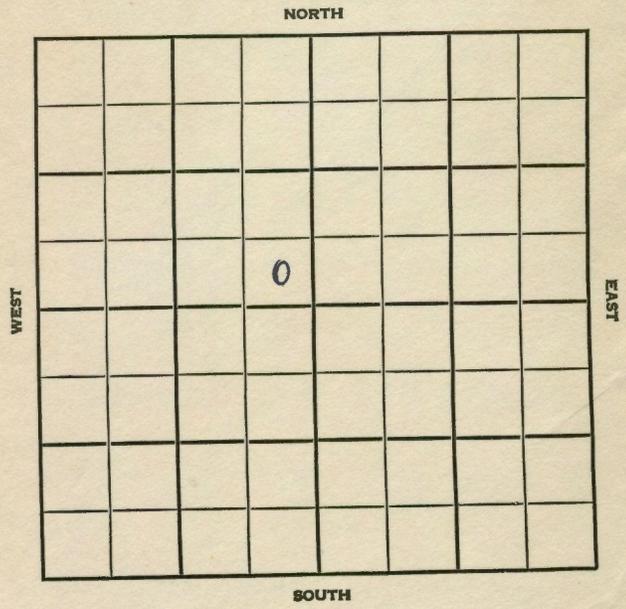

_____ Ft. from N. Line

330 Ft. from S. Line

330 Ft. from E. Line

_____ Ft. from W. Line

SE SE NW

	ELEVATION	REPORT
1954	2355'	

8/18 Spud 8-11-54
8" @ 290'
rlg. 2980'

10/6 Spud 8-11-54 - Oil Well
TD 3686'
8" @ 290'
Anhy 1950', Heeb 3400', KC 3442',
B KC 3627', Arb. 3683'
TD 3686'
5" @ 3684'
CO to 3686' 1000A
S/10 boph
Comp. 160 bopd

COMPLETED

6

