

Norton

KANSAS


NORTON

KANSAS

SECTION ~~#~~ 33 TOWNSHIP 3 RANGE 23W

WELL NO. #1 LeBeau

COMPANY Jones, Shelburne & Farmer

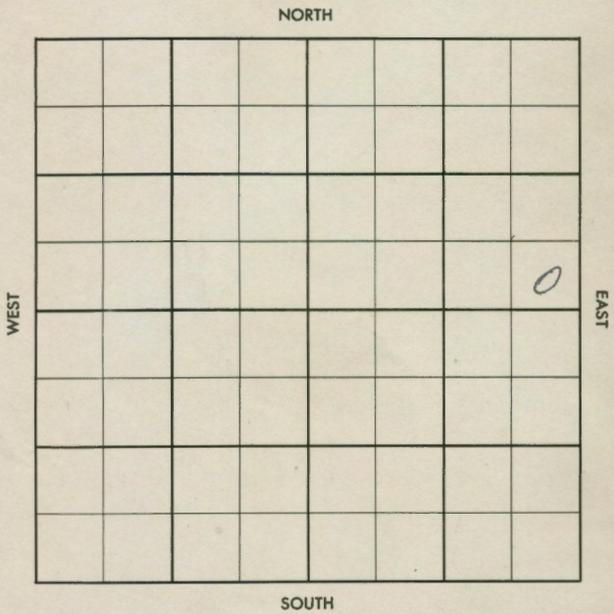

8

SEC. 33 TWP. 3 R. 23W


WELL NO. #1 LeBeau FARM

COMPANY Jones, Shelburne & Farmer

CONTRACTOR Co. Tools

WILDCAT

\_\_\_\_\_ Ft. from N. Line  
 \_\_\_\_\_ Ft. from S. Line  
 \_\_\_\_\_ Ft. from E. Line  
 \_\_\_\_\_ Ft. from W. Line

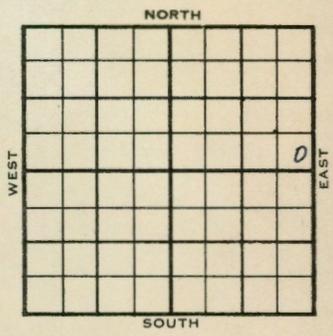

SE SE NE

1956	ELEVATION	REPORT
	2418	

3-28 Comm. 3-23-56  
 8" @  
 Drlg. 11406

4-11 8 5/8" @ 268 w/135  
 DST 3519-47 op 1 hr. rec. 285' msw,  
 1200/20"  
 D & A  
 H. 3465  
 Tr. 3495  
 L. 3508  
 BKC 3691  
 R. Sd 3744  
 G. wh. 3752  
 Gr. 3775  
 TD 3784

ABANDONED

County Norton Elev. 2118  
 Sec. 33 Twp. 3 Rge. 23W  
 Company Jones, Shelburne & Farmer  
 FarmName LeBeau No. 1

TOPS	DEPTH	LOG	DATUM	Loc. in Sec.
Anh.				SE SE NE
Tr.				
H.	<u>3465</u>			
Tr.	<u>3495</u>			
Dg.				
Bl.				
L.	<u>3508</u>		<u>1090</u>	Geol.
K.C.				Contr.
B.K.C.	<u>3691</u>		<u>1273</u>	Co. tools
Ce.				Pool
C.				Wildcat
M.				
M.				
K.				
Mz.				
Mo.				
V.				
S.				
S.				
A				
R.	<u>3744</u>		<u>1326</u>	ABANDONED
Pe.				
G.	<u>3752</u>		<u>1334</u>	
G.	<u>3775</u>		<u>1357</u>	
T.D.	<u>3784</u>			

Date Comm. 3-23-56 APR 1 1 1956  
8 5/8" @ 268/135 DST 3519-47  
open 1 hr. rec. 285' msw 1200/20"

D & A

County Norton Elev. 2318  
 Sec. 33 Twp. 3 Rge. 23W  
 Company Jones, Shelburne & Farmer  
 FarmName LeBeau No. 1

TOPS	DEPTH	LOG	DATUM	Loc. in Sec.
Anh.				SE SE NE
Tr.				
H.				
Tr.				
Dg.				
Bl.				
L.				Geol.
K.C.				Contr.
B.K.C.				Co. tools
Ce.				Pool
C.				Wildcat
M.				
M.				
K.				
Mz.				
Mo.				
V.				
S.				
S.				
A				
R.				
Pe.				
G.				
T.D.				

Date Comm. 3-23-56  
8" @ drlg. 1406

FIRST REPORT  
 MAR 28 56

*(Handwritten signature)*