


Norton

KANSAS

Section 30 Township 3 Range 23W  
 Well No. #11 Weber  
 Company D. G. Hansen

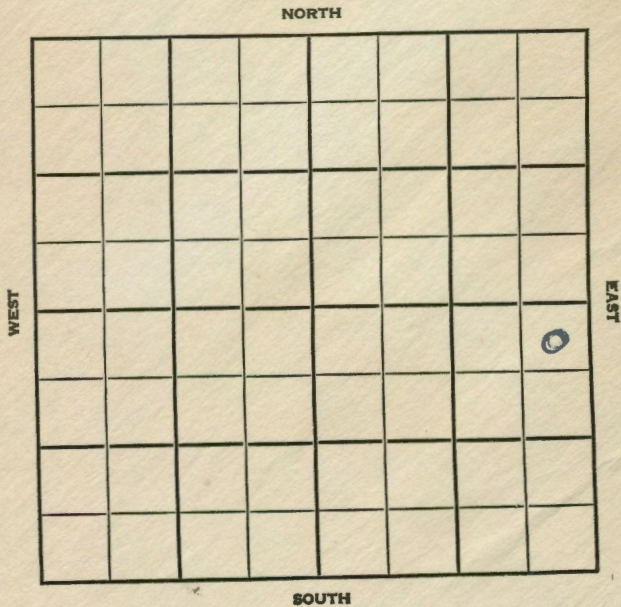

9

NORTON

SEC. 30	TWP. 3	R. 23W
---------	--------	--------

KANSAS

WELL NO. #11 Weber FARM

COMPANY D.G. Hansen

CONTRACTOR C & G Drlg.

Norton Pool

330 Ft. from N. Line

330 Ft. from S. Line

330 Ft. from E. Line

Ft. from W. Line

NE NE SE

	ELEVATION	REPORT
1954	2467'	
11/11	Location	
1955	Oil Well	
1/26	TD 3799'	
	8-5/8" @ 307'	
	Anhy 2063', Heeb. 3520', Tor 3544',	
	ans. 3560', B KC 3741', Arb. 3795'	
	TD 3798'	
	5" @ 3796'	
	DD 3799'	
	P 4 boph	
	Comp. 108 bopd	
	COMPLETED	

