
Norton KANSAS

DX 78-1

Section 30 Township 3 Range 23W

Well No. 9 Weber

Company D. G. Hansen

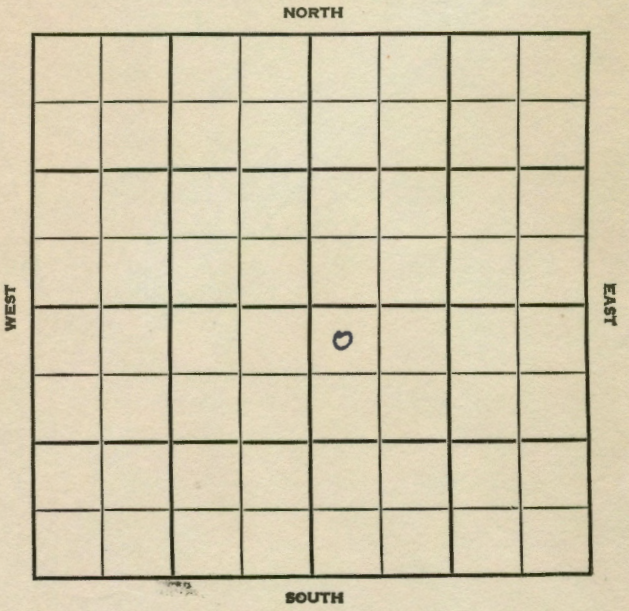

10

Norton KANSAS

SEC.	TWP.	R.
30	3	23W

WELL NO. 9 Weber

FARM

COMPANY D. G. Hansen

CONTRACTOR C & G Drlg.


440 Ft. from N. Line

Ft. from S. Line

Ft. from E. Line

440 Ft. from W. Line

NW NW SE

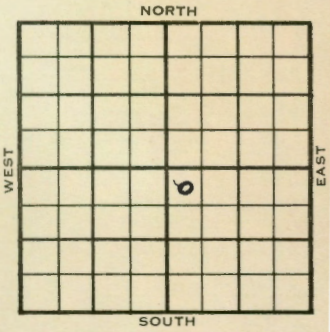

1954	ELEVATION 2420	REPORT
7/23	Spdg 7-14-54 8" @ 248 Anhy 2014 Heeb 3467 Tor. 3492 Lans 3508 Drlf 3550	
7/28	B KC 3693', Arb. 3744' RTD 3747' 5" @ 3745'	
9/1	Spud 7-14-54 Oil well TD 3749 8" @ 248 Anhy 2014 Heeb 3467 Tor. 3492 Lans 3508 B KC 3687 5" @ 3745 DD 3749 P/4 BOPH 12 hr. Comp. 172 BOPD COMPLETED	

DX-78

FORM 275 FOR SALE BY KANSAS BLUE PRINT CO.


County Norton State Kansas

Sec. 30 (Blk. Twp.) 3 (Sur. Rge.) 23W Map No.

Operator D. G. Hansen

Well No. 9 Farm Weber

Elev. 2420 Location NW NW SE

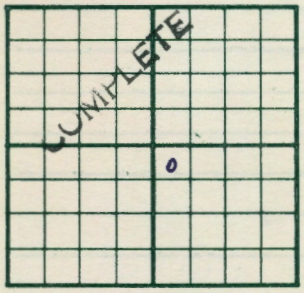

440 Ft. From N Line SE

440 Ft. From W Line Quarter

1st. Report

Completion SEP 1 1954

Remarks C & G Drlg. - Contr.

Spudding Date 7-14-54

Drlg. Data Oil well TD 3749

8" @ 248 Anhy 2014 Heeb. 3467

Tor. 3492 Lans. 3508 B KC 3747

5" @ 3745 DD 3749 P/ 4 boph 12 hr.

Comp. 172 bopd

FABEN GILSTRAP

FORM 275 FOR SALE BY KANSAS BLUE PRINT CO.

County Norton State Kansas

Sec. 30 (Blk. Twp.) 3 (Sur. Rge.) 2 3W Map No.

Operator D. G. Hansen

Well No. 9 Farm Weber

Elev. 2420 Location NW NW SE



440 Ft. From N Line SE

440 Ft. From W Line Quarter

1st. Report JUL 21 1954

Completion

Remarks C & G Drlg. - Contr.

Spudding Date 7-14-54

Drlg. Data

8" @ 248 Anhy 2014 Heeb. 3467

Tor. 3492 Lans. 3508 drlg. 3550

J. G. McGEHEE