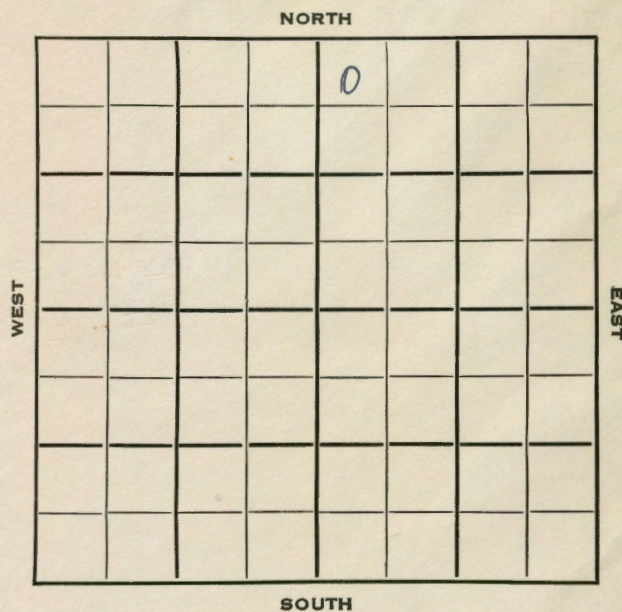


Norton KANSAS

Section 5 Township 3 Range 23 WWell No. # 1 ColemanCompany Jones, Shelburne & Farmer

2

SEC. <u>5</u>	TWP. <u>3</u>	R. <u>23 W</u> ✓
WELL NO. <u># 1 Coleman</u>		
COMPANY <u>Jones, Shelburne & Farmer</u>		
CONTRACTOR <u>J-S-F</u>		
<u>Wildcat</u>		


330 Ft. from N. Line

Ft. from S. Line

Ft. from E. Line

330 Ft. from W. Line

NW NW NE

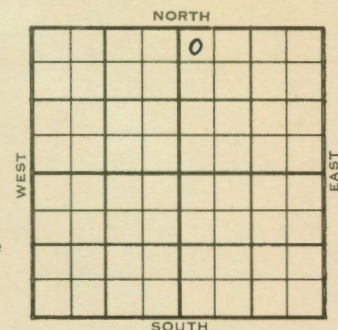

1953	ELEVATION <u>2357'</u>	REPORT
12/22	Location	
1954 1/6	Spud 12-21-53 D & A TD 3655 8" @ 280 Heeb 3365 Lans. 3411 DST 3490-3525, open 10 min, rec 6' mud 780# DST 3546-70, open 1/2 hr, rec 5' mud 340# Gr. wash 3629' Gr. 3644' TD 3655' D & A	

ABANDONED

0

ABANDONED

J. G. McGEHEE



 FIRST REPORT

J. G. McGEHEE