


Section 29 Township 3 Range 23W

Well No. #3 Cope

Company D.G. Hansen

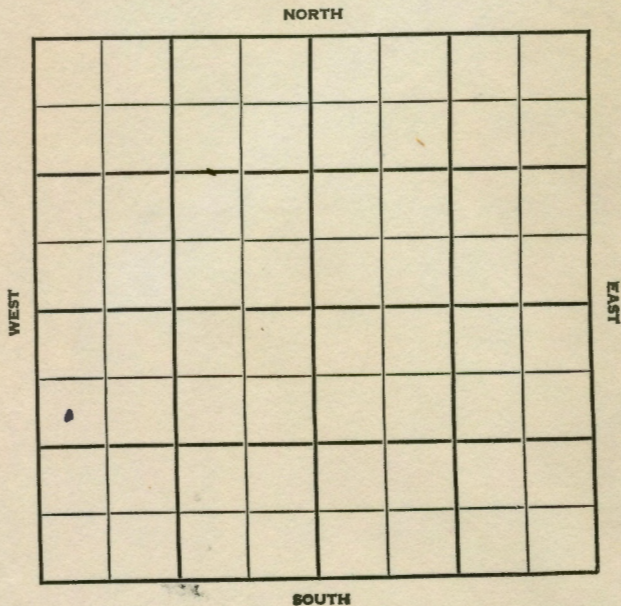

12

SEC.	29	TWP.	3	R.	23W
WELL NO. 3 Cope FARM					
COMPANY D. G. Hansen					
CONTRACTOR C & G Drlg. Norton Pool					
990	Ft. from N. Line				
	Ft. from S. Line				
	Ft. from E. Line				
440	Ft. from W. Line				
SW NW SW					

	ELEVATION	REPORT
1955	2454'	
2/9	MIR	
2/23	Spud 2-8-55 D & A TD 3848' 8" @ 306' Anhy 2051', Heeb 3503' Tor. 3527' Lans 3544' DST 3781'-85' opn 1/2 hr, rec 6' rotary mud, 700# B KC 3730', Cong 3780' Arb. 3789' DST 3788'-92' opn 1/2 hr, rec 21' Mud 35# Reagan 3832' DST 3792'-97' opn 1 hr, rec 61' socm, 100' wtr, 770# Gr. Wash 3837', Gr. 3847' TD 3848' D & A	
		ABANDONED

County Norton State Kansas  
 Sec. 29 (Blk. 3 (Sur. 23W Map No. 3)  
 Operator D. G. Hansen  
 Well No. 3 Farm Cope  
 Elev. 2454 Location SW NW SW


990 Ft. From N Line SW  
440 Ft. From W Line Quarter  
 Ist. Report  
 Completion FEB 23 1955  
 Remarks Norton Pool  
C & G Drlg. - Contr.  
 Spudding Date 2-8-55

Drlg. Data D & A TD 3848  
8" @ 306 Anhy 2051 Heeb. 3503  
Tor. 3527 Lans. 3544 DST 3781-85  
open 1/2 hr. Rec. 6' rotary mud 700#  
B KC 3730 Cong. 3780 Arb. 3789  
DST 3788-92 open 1/2 hr. Rec. 21' mud  
35# Ragan 3832 DST 3792-97 open 1 hr.  
Rec. 61' socm 100' wtr. 770#  
Gr. wash 3837 Gr. 3847 TD 3848  
D & A

FABEN GILSTRAP

County Norton State Kansas  
 Sec. 29 (Blk. 3 (Sur. 23W Map No. 3)  
 Operator D. G. Hansen  
 Well No. 3 Farm Cope  
 Elev. Location SW NW SW


990 Ft. From N Line SW  
440 Ft. From W Line Quarter  
 Ist. Report FEB 9 1955  
 Completion  
 Remarks C & G Drlg. - Contr.  
 Spudding Date

Drlg. Data Norton Pool  
MIR

FABEN GILSTRAP