

Section 29 Township 3 Range 23W

Well No. #4 Cope


Company D.G. Hansen

SEC.	TWP.	R.
29	3	23W


WELL NO. 4 Cope FARM

COMPANY D. G. Hansen

CONTRACTOR C & G Drlg. Norton Pool

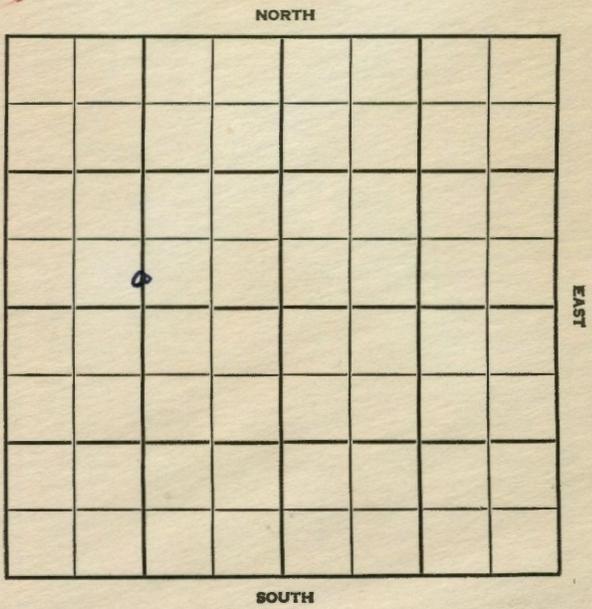

\_\_\_\_\_ Ft. from N. Line  
 330 \_\_\_\_\_ Ft. from S. Line  
 \_\_\_\_\_ Ft. from E. Line  
 1320 \_\_\_\_\_ Ft. from W. Line

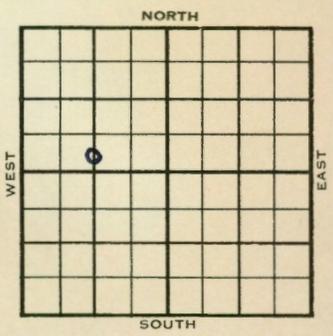

C S/2 S/2 NW

1955	ELEVATION	REPORT
------	-----------	--------

2/16 Cellar & Pits

6

