


Section 10 Township 3 Range 23WWell No. #1 HoreskyCompany Brooks Hall

NORTH

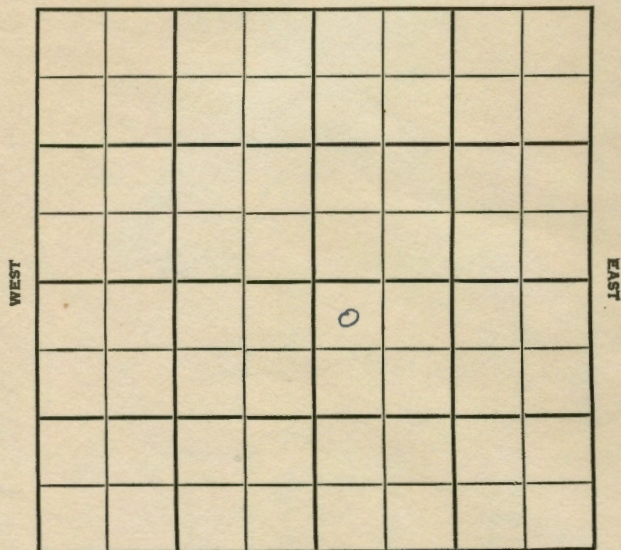

SOUTH

10

SEC.

10

TWP.

3

R.

23W

WELL NO.

#1 Horesky

FARM

COMPANY

Brooks Hall

CONTRACTOR

J-S-F

WILDCAT

FT. FROM N. LINE


FT. FROM S. LINE

FT. FROM E. LINE

FT. FROM W. LINE

NW NW SE

NORTH

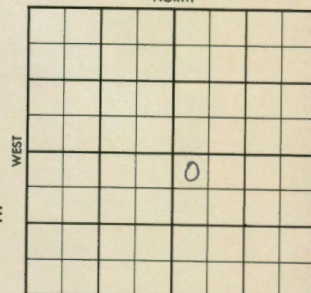

SOUTH

1956

ELEVATION

2331'

REPORT

8-22

Comm. 8-20-56
8" @ 170 w/125
WOC

8-29

DST 3636-43 op 15 min. rec. 15' VSOCM,
BHP 680/20".DST 3638-47 op 1 hr., rec. 3' oil /
55' MSW, BHP 880/20".

No log.

D & A

Anh. 1916'; H. 3373'; Tr. 3379';

L. 3414'; BKC 3599'; A. 3636';

G. Wh. 3649';

TD 3682'

ABANDONED

County Norton Elev. 3331
 Sec. 10 Twp. 3 Rge. 23W
 Company Brooks Hall
 FarmName Horesky No. 1

TOPS	DEPTH	LOG	DATUM	Loc. in Sec.
Anh.	1916			NW NW SE
Tr.				
H.	3323			
Tr.	3377			
Dg.				
BL.				
L.	3414			Geol.
K.C.				Contr.
B.K.C.	3599			J-S-F
Ce.				Pool
C.				Wildcat
M.				
M.				
K.				
Mz.				
Me.				
V.				
S.				
S.				
A.	3636			
R.				
Pe.				
G.	3649			
TD.	3682			

Date Comm. 8-20-56

AUG 29 1956

8" @ 170/125 WOC AUG 29 * DST 3636
 -43 15" rec 15' VSDCM
 BHP 680/20 DST 3638-47
 1hr rec 3' oil + 55' MSW
 BHP 880/20 No log

D&A

County Norton Elev. 3331
 Sec. 10 Twp. 3 Rge. 23W
 Company Brooks Hall
 FarmName Horesky No. 1

TOPS	DEPTH	LOG	DATUM	Loc. in Sec.
Anh.				NW NW SE
Tr.				
H.				
Tr.				
Dg.				
BL.				
L.				Geol.
K.C.				Contr.
B.K.C.				J-S-F
Ce.				Pool
C.				Wildcat
M.				
M.				
K.				
Mz.				
Me.				
V.				
S.				
S.				
A.				
R.				
Pe.				
G.				
TD.				

Date Comm. 8-20-56

8" @ 170/125 WOC

0201 P S DUA

D&A