


Section 12 Township 3 Range 23 WWell No. # 1 MuirCompany Great Lakes Carbon Corp.

NORTH

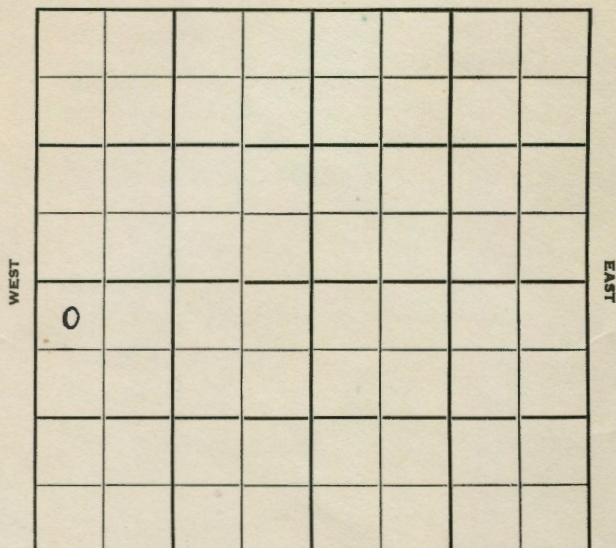

SOUTH

12

Sec. 12 Twp. 3 R. 23 W ✓Well No. # 1 Muir

Farm

Great Lakes Carbon Corp.

Company

Contractor

Wildcat330 Ft. from N. Line


Ft. from S. Line

Ft. from E. Line

330 Ft. from W. Line

NW NW SW

NORTH

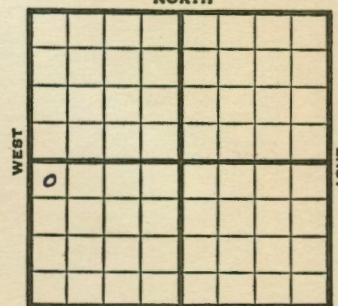

SOUTH

1951

Elev. 2341' REPORT

6/27

Spud 6-24-51

8" @ 218

Drlg. 821'

7/11

Spud 6-24-51

D&amp;A TD 3722

8" @ 218

Heeb. 2308

Tor 3428

Lans. 3450

Cong. 3680

Arb. 3686

DST 3687-92 opn 1 hr Rec. 160' sw

Granite Wash 3694 Granite 3705

TD 3722 D&amp;A

**ABANDONED**

[illegible]

J. E. TYRA

[illegible]

J. E. TYRA

Check County  
Advise

W. W. JUL 12 1951  
JUL 2 1951

|                |  |
|----------------|--|
| Scout Cards    |  |
| Land Small Map |  |
| Land Wall Map  |  |
| Tracings       |  |
| France Map     |  |
| Pierce Map     |  |
| Misc.          |  |

Orig. Data