


Norton

KANSAS

Section 15 Township 3 Range 23W
 Well No. #1 Horesky
 Company C & G & DG Hansen

NORTH

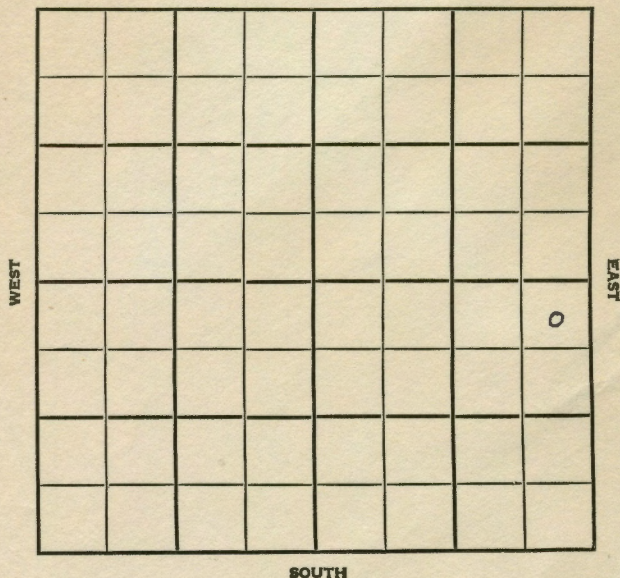

SOUTH

EAST

8

SEC.

TWP.

R.

Norton

KANSAS

SEC. 15 TWP. 3 R. 23W
 WELL NO. #1 Horesky FARM
 COMPANY C & G & D.G. Hansen
 CONTRACTOR Co. Tools.

Wildcat.

330

Ft. from N. Line


Ft. from S. Line

330

Ft. from E. Line

Ft. from W. Line

NORTH

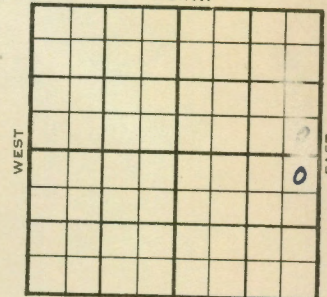

SOUTH

NE NE SE
 Skelly - DHM

1954

ELEVATION

2426'

REPORT

12/15

Spud 12-10-54

8" @ 308'

Anhy 2005'

Drlg. 3065'

12/22

Spud 12-10-54

D & A

TD 3810'

8" @ 308'

Anhy 2005', Heeb 3475' Tor 3501'

Lans 3516', BKC 3703' Arb. 3737'

DST 3738'-43' opn 1 hr, rec 70' ocm,
60' wtr. 945# Gr. Wash 3746' Gr. 3760'

TD 3810'

LogTops: Heeb 3474', Tor 3498' Lans


3514' Arb. 3736', Gr. Wash 3746', Gr.

3760'

D & A

ABANDONED

County Norton State Kansas
 Sec. 15 (Blk. 3 (Sur. 23W Map No.
 (Twp.) (Rge.)
 Operator C & G Drlg. & D. G. Hansen
 Well No. 1 Farm Horesky
 Elev. 2426 Location NE NE SE

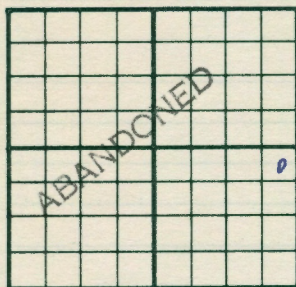


330 Ft. From N Line SE
330 Ft. From E Line Quarter
 Ist. Report
 Completion DEC 22 1954
 Remarks Wildcat
Co. tools
 Spudding Date 12-10-54

Drlg. Data D & A TD 3810
8" @ 308 Anhy 2005 Heeb. 3475
Tor. 3501 Lans. 3516 B KC 3703
Arb. 3737 DST 3738-43 open 1 hr.
Rec. 70' ocm 60' wtr. 945#
Gr. wash 3746 Gr. 3760 TD 3810
LOG TOPS:
Heeb. 3474 Tor. 3498 Lans. 3514
Arb. 3736 Gr. wash 3746 Gr. 3760
D & A

FABEN GILSTRAP

County Norton State Kansas
 Sec. 15 (Blk. 3 (Sur. 23W Map No.
 (Twp.) (Rge.)
 Operator C & G and D. G. Hansen
 Well No. 1 Farm Horesky
 Elev. Location NE NE SE

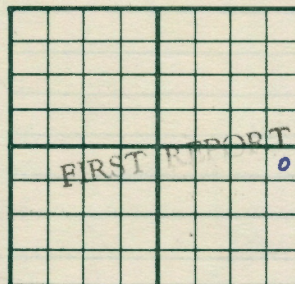

330 Ft. From N Line SE
330 Ft. From E Line Quarter
 Ist. Report DEC 15 1954
 Completion
 Remarks Skelly - DHM
Co. tools
 Spudding Date 12-10-54

Drlg. Data Wildcat
8" @ 308 Anhy 2005 drlg. 3065

FABEN GILSTRAP