FORM 51 Norton KANSAS

Section 30 Township 3 Range 23 W

Well No. # 8 Weber

Company D. G. Hansen

NORTH

WEST

EAST

SOUTH

11

Norton KANSAS

SEC.	TWP.	R.
30	3	23W

WELL NO. 8 Weber FARM

COMPANY D. G. Hansen

CONTRACTOR C & G Drlg.

Norton Pool

330 Ft. from N. Line

Ft. from S. Line

330 Ft. from E. Line

Ft. from W. Line

NE NE SW

NORTH

WEST

EAST

SOUTH

1954	ELEVATION 2393' REPORT
5/12	Location
5/19	8" @ 260 w/170 Anhy 1985 Heeb 3438 Tor 3464 Lans 3478 DST 3494-3516, 1¼ hr, 20' M, 60' wtr. 65' MCW 760# Drlg.
5/26	B KC 3664' Arb. 3716' RTD 3720' 5" @ 3717
6/2	WOCT
6/9	WOCT
6/23	CO 3720' DD 3722', FU 750' oil 2 hrs., POP ¼ 8½ boph 14 hrs.
6/30	NR
7/7	"
7/28	Spud 5-11-54 Oil well TD 3722 8" @ 260 Anhy 1985' Heeb 3438 Tor. 3464' Lans 3478' DST 3494-3516, open 1¼ hr, rec 20' mud, 60' wtr. 65' MCW 760# B KC 3664 Arb. 3716' TD 3720 5" @ 3717 CO to 3720 DD 3722 FU 750' oil 2 hr. P/8½ BOPH 4 hr. Comp. 182 BOPD

DX-78

COMPLETED

FORM 275 FOR SALE BY KANSAS BLUE PRINT CO.


County Norton State Kansas

Sec. 30 (Blk. Twp.) 3 (Sur. Rge.) 23W Map No.

Operator D. G. Hansen

Well No. 8 Farm Weber

Elev. 2393 Location NE NE SW

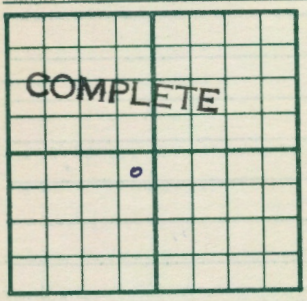

330 Ft. From N Line SW

330 Ft. From E Line Quarter

1st. Report

Completion JUL 2 8 1954

Remarks Norton Pool

C & G Drlg. - Contr.

Spudding Date 5-11-54

Drlg. Data Oil well TD 3722

8" @ 260 Anhy 1985 Heeb. 3438

Tor. 3464 Lans. 3478 DST 3494-3516

open 1¼ hr. Rec. 20' mud 60' wtr.

65' mcw 760# B KC 3664 Arb. 3716

TD 3720 5" @ 3717 CO to 3720 DD 3722

FU 750' oil 2 hr. P/ 8½ boph 4 hr.

Comp. 182 bopd

J. G. McGEHEE

FORM 275 FOR SALE BY KANSAS BLUE PRINT CO.


County Norton State Kansas

Sec. 30 (Blk. Twp.) 3 (Sur. Rge.) 23W Map No.

Operator D. G. Hansen

Well No. 8 Farm Weber

Elev. Location NE NE SW

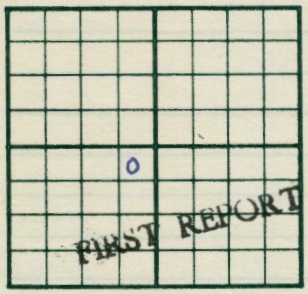

330 Ft. From N Line SW

330 Ft. From E Line Quarter

1st. Report MAY 1 2 1954

Completion

Remarks

C & G Drlg. - Contr.

Spudding Date

Norton Pool

Drlg. Data

Location

J. G. McGEHEE