


Section 30 Township 3 Range 23W
 Well No. #6 ~~#8~~ Weber
 Company D.G. Hansen

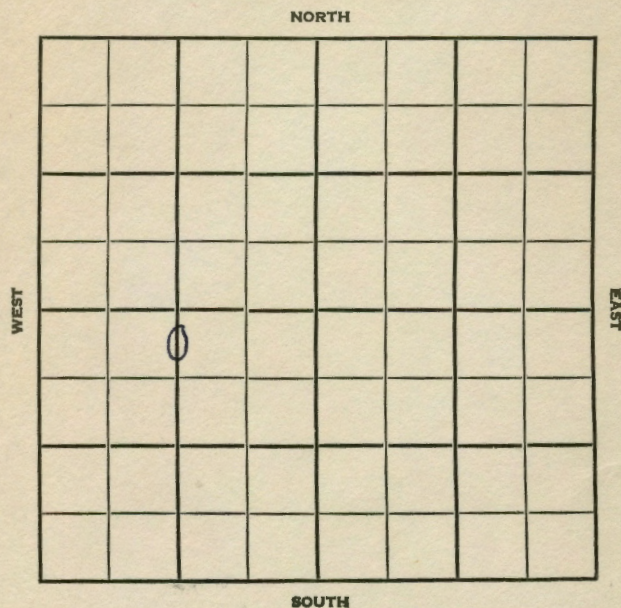


11

NORTON

SEC. 30 TWP. 3 R. 23W **KANSAS**
 WELL NO. #6 Weber FARM
 COMPANY D.G. Hansen
 CONTRACTOR c & G Drlg. Co.

440 Ft. from N. Line
 _____ Ft. from S. Line
 _____ Ft. from E. Line
1320 Ft. from W. Line

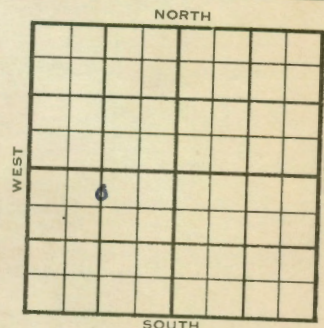C N $\frac{1}{2}$ N $\frac{1}{2}$ SW

	ELEVATION	REPORT
1954	2363'	
5/5	Spud 4-26-54 Heeb 3403', Tor 3429', KC 3445' B KC 3633', Reagan 3689' TD 3693' 5" @ ? DST 3690'-93' opn 1 hr, rec 630' oil 25' muddy oil, 165' gas. 820#	
5/12	NR	
6/23	NR	
6/30	"	
7/14	Spud 4-26-54 Oil well TD 3694 8" @ 254 Heeb 3403 Tor. 3429 KC 3445 B KC 3633 Reagan 3689 TD 3693 5" @ 3691 DST 3690-93, open 1 hr, rec 630' oil, 25' muddy oil, 165' gas 820# DD 3694 S/7 $\frac{1}{2}$ BOPH Comp. 158 BOPD	

COMPLETED

J. G. McGEHEE

J. G. McGEHEE