


Norton

KANSAS

Section 30 Township 3 Range 23WWell No. #12 WeberCompany D. G. Hansen

NORTH

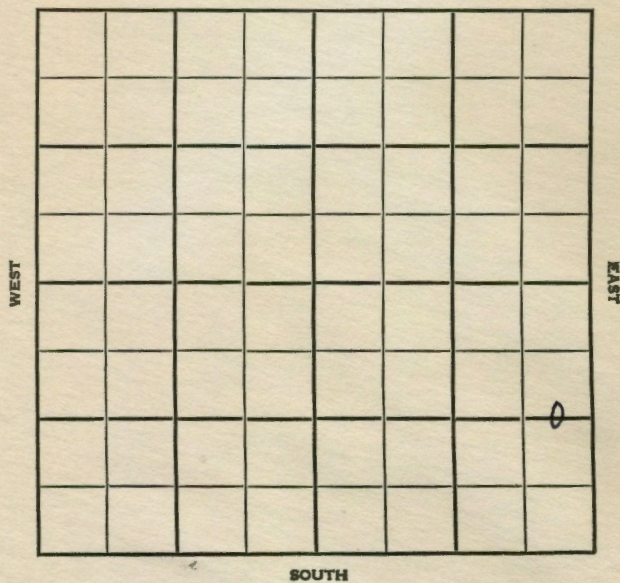

SOUTH

9

Norton

KANSAS

SEC. 30 TWP. 3 R. 23W

#12 Weber

COMPANY D. G. Hansen FARM

CONTRACTOR

C & G Drlg.

Norton Pool

Ft. from N. Line


1320 Ft. from S. Line

330 Ft. from E. Line

Ft. from W. Line

C E $\frac{1}{2}$ E $\frac{1}{2}$ SE

NORTH

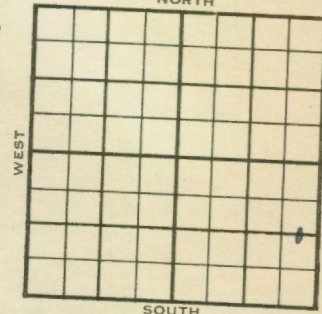

SOUTH

1954

ELEVATION

2449'

REPORT

11/23

Spud 11-14-54

8" @ 303'

Tor. 3526' Lans 3545'

Drlg. 3600'

1955

1/26

Spud 11-14-54 - Oil Well

TD 3783'

8" @ 303'

Tor. 3526', Lans 3545', B KC 3730',

Arb. 3778'

TD 3782'

DST 3779-82', opn 1 hr., rec. 65'

muddy oil, 705#

5" @ 3780'

DD 3783'


B/3 boph

Reagan 3782'

Comp. 43 bopd

COMPLETED

County Norton State Kansas
 Sec. 30 (Blk. Twp.) 3 (Sur. Rge.) 23W Map No.
 Operator D. G. Hansen
 Well No. 12 Farm Weber
 Elev. 2449 Location C E $\frac{1}{2}$ E $\frac{1}{2}$ SE

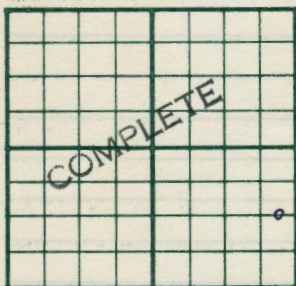


1320 Ft. From S Line SE
330 Ft. From E Line Quarter
 Ist. Report
 Completion JAN 26 1955
 Remarks Norton Pool
C & G Drlg. - Contr.
 Spudding Date 11-14-54

Drlg. Data Oil well TD 3783
8" @ 303 Tor. 3526 Lans. 3545
B KC 3730 Arb. 3778 TD 3782 DST 3779-82
open 1 hr. Rec. 65' muddy oil 705#
5" @ 3780 DD 3783 B/ 3 boph
Reagan 3782 Comp. 43 bopd

FABEN GILSTRAP

County Norton State Kansas
 Sec. 30 (Blk. Twp.) 3 (Sur. Rge.) 23W Map No.
 Operator D. G. Hansen
 Well No. 12 Farm Weber
 Elev. Location C E $\frac{1}{2}$ E $\frac{1}{2}$ SE

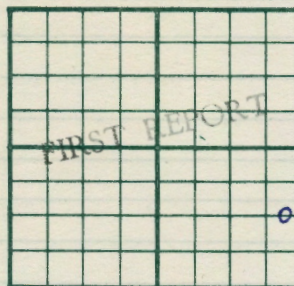

1320 Ft. From S Line SE
330 Ft. From E Line Quarter
 Ist. Report NOV 23 1954
 Completion
 Remarks
C & G Drlg. - Contr.
 Spudding Date 11-14-54

Drlg. Data Norton Pool
8" @ 303 Tor. 3526 Lans. 3545
drlg. 3600

FABEN GILSTRAP