


KANSAS

Section 30 Township 3 Range 23W  
 Well No. #13 Weber  
 Company D.G. Hansen

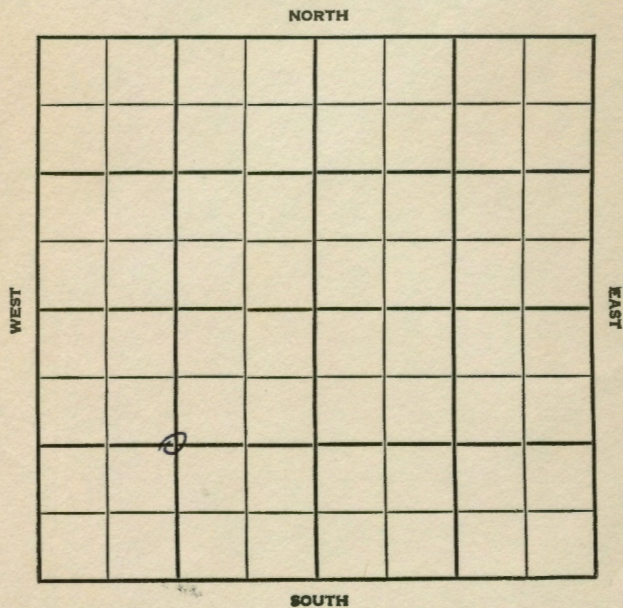


11

SEC. 30 TWP. 3 R. 23 W  
 WELL NO. # 13 Weber FARM  
 COMPANY D. G. Hansen  
 CONTRACTOR C & G Drlg.

Norton Pool  
1320 Ft. from N. Line  
1320 Ft. from S. Line  
1320 Ft. from E. Line  
1320 Ft. from W. Line

C SW/4

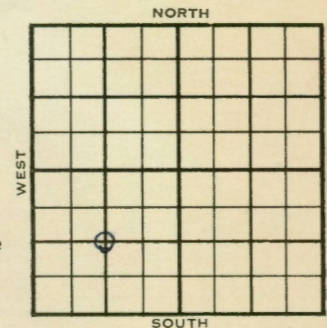

|             | ELEVATION   | REPORT |
|-------------|---|--------|
| 1954        | 2343'   |        |
| 12/22       | Spud 12-18-54<br>8" @ 218'<br>Drlg. 1480'   |        |
| 1955<br>2/2 | Spud 12-18-54<br>Oil Well<br>TD 3673'<br>8" @ 218'<br>Anhy 1933' Heeb 3388' Tor 3414'<br>Lans 3428' B KC 3612' Arb. 3668'<br>TD 3672'<br>5" @ 3669'<br>CO 1 boph 3 hr. DD 3673<br>4 boph 3 hr.<br>Comp 164 bopd. |        |

COMPLETED

County Norton State Kansas  
 Sec. 30 (Blk. 3 (Sur. 23W Map No.  
 Operator D. G. Hansen  
 Well No. 13 Farm Weber  
 Elev. 2543 Location C SW/4

|  |  |  |  |  |  |
|--|--|--|--|--|--|
|  |  |  |  |  |  |
|  |  |  |  |  |  |
1320 Ft. From S Line SW  
 1320 Ft. From W Line Quarter  
 Ist. Report DEC 22 1954  
 Completion  
 Remarks C & G Drlg. - Contr.  
 Spudding Date 12-18-54

Drlg. Data Norton Pool

8" @ 218 drlg. 1490

FABEN GILSTRAP

County Norton State Kansas  
 Sec. 30 (Blk. 3 (Sur. 23W Map No.  
 Operator D. G. Hansen  
 Well No. 13 Farm Weber  
 Elev. 2343 Location C SW/4

|  |  |  |  |  |  |
|--|--|--|--|--|--|
|  |  |  |  |  |  |
|  |  |  |  |  |  |
1320 Ft. From S Line SW  
 1320 Ft. From W Line Quarter  
 Ist. Report  
 Completion FEB 2 1955  
 Remarks Norton Pool  
C & G Drlg. - Contr.  
 Spudding Date 12-18-54

Drlg. Data Oil well TD 3673

8" @ 218 Anhy 1933 Heeb. 3388

Tor. 3414 Lans. 3428 B KC 3612

Arb. 3668 TD 3672 5" @ 3669

CO 1 boph 3 hr. DD 3673

4 boph 3 hr. Comp. 164 bopd

FABEN GILSTRAP