


Section 30 Township 3 Range 23W

Well No. 14 Weber

Company D. G. Hansen

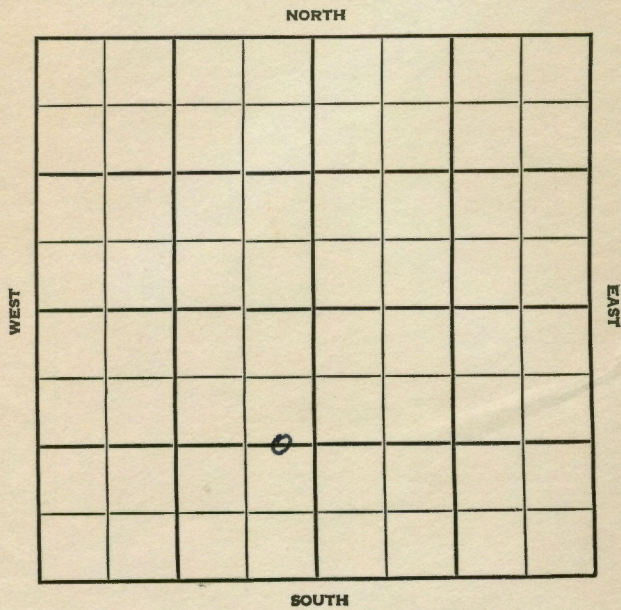

11

KANSAS

SEC.	30	TWP.	3	R.	23 W
------	----	------	---	----	------

WELL NO. # 14 Weber FARM

COMPANY D. G. Hansen

CONTRACTOR C & G Drlg. Norton Pool

_____ Ft. from N. Line

1320 _____ Ft. from S. Line

330 _____ Ft. from E. Line

_____ Ft. from W. Line

C E 1/2 E 1/2 SW

	ELEVATION	REPORT
1955	2399 RB	
1/5	Spud 12-30-54 8" @ 270 Anhy 1988 Heeb 3446 Drlg. 3463'	
1/12	Spud 12-30-54 D & A TD 3863' 8" @ 270' Anhy 1988', Heeb 3446', Tor. 3472' Lans 3486', B KC 3672' Cong. 3725' DST 3726'-29' opn 1 hr, rec 15' ocm, 15' Mud. 105# Arb. 3730' DST 3726'-33' opn 1 hr, rec 15' Mud 60' msw, 565# Reagan 3742' Gr. W. 375 Weathered Gr. 3801', Gr. 3861' TD 3863' D & A	
		ABANDONED

County Norton State Kansas

Sec. 30 (Blk. Twp.) 3 (Sur. Rge.) 23W Map No.

Operator D. G. Hansen

Well No. 14 Farm Weber

Elev. 2399 Location C E $\frac{1}{2}$ E $\frac{1}{2}$ SW

ABANDONED									

1320 Ft. From S Line SW

330 Ft. From E Line Quarter

1st. Report

Completion JAN 1 2 1955

Remarks Norton Pool

C & G Drlg. - Contr.

Spudding Date 12-30-54

Drlg. Data D & A TD 3863

8" @ 270 Anhy 1988 Heeb. 3446

Tor. 3472 Lans. 3486 B KC 3672

Cong. 3725 DST 3726-29 open 1 hr.

Rec. 15' ocm 15' mud 105# Arb. 3730

DST 3726-33 open 1 hr. Rec. 15' mud

60' msw 565# Reagan 3742 Gr.W 3758

Weathered Gr. 3801 Gr. 3861 TD 3863

D&A

FABEN GILSTRAP

County Norton State Kansas

Sec. 30 (Blk. Twp.) 3 (Sur. Rge.) 23W Map No.

Operator D. G. Hansen

Well No. 14 Farm Weber

Elev. 2399 RB Location C E $\frac{1}{2}$ E $\frac{1}{2}$ SW

FIRST REPORT									

1320 Ft. From S Line SW

330 Ft. From E Line Quarter

1st. Report IAN 5 1955

Completion

Remarks

C & G Drlg. - Contr.

Spudding Date 12-30-54

Drlg. Data Norton Pool

8" @ 270 Anhy 1988 Heeb. 3446

drlg. 3463

FABEN GILSTRAP