


Section 30 Township 3 Range 23W

Well No. #4 Horning

Company Harry Gore

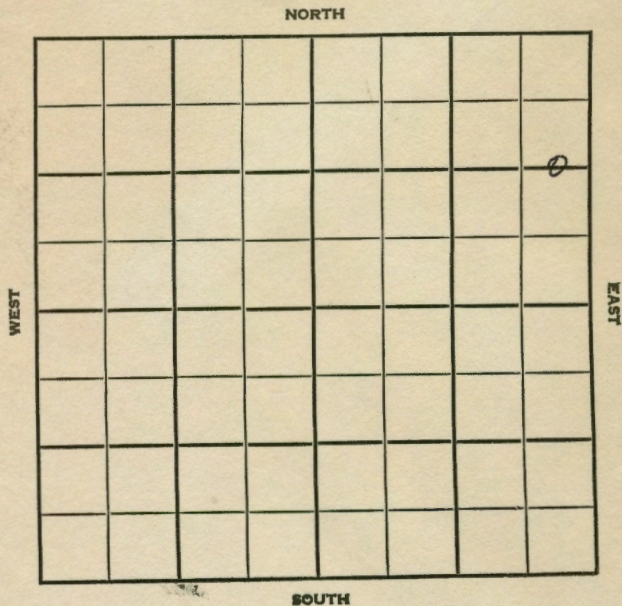

SEC. 30 TWP. 3 R. 23W

WELL NO. 4 Horning FARM

COMPANY Harry Gore

CONTRACTOR Empire


Norton Pool

1320 Ft. from N. Line

_____ Ft. from S. Line

440 Ft. from E. Line

_____ Ft. from W. Line

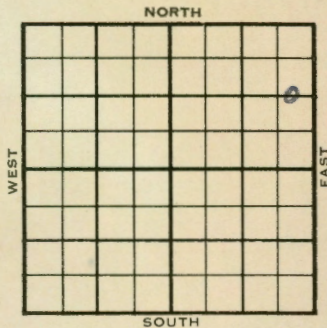

C E/2 E/2 NE

	ELEVATION	REPORT
1955	2456'	

2/23 MIR

3/23 Spud 2-22-55, Oil Well, TD 3785
 8" @ 303, Anhy 2054, Heeb 3505,
 Tor. 3531, Lans 3545, B KC
 3725, DeTyrdal 3780,
 DST 3780-85 open 1 hr Rec 390'
 oil, 90' mo, 650#, TD 3785
 5" @ 3781, CO to 3785, FU
 1500' oil 9 hr, P/84 BO 12 hr
 P/6 BOPH 6 hr. P/109 BO 17 hr
 Comp. 132 BOPD

COMPLETED

