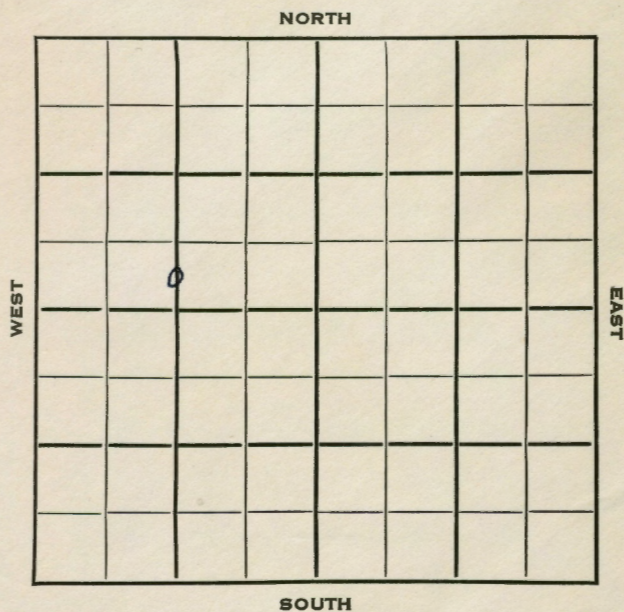


KANSAS

Section 30 Township 3 Range 23WWell No. #6 Calvin LawsonCompany Harry Gore

SEC.	30	TWP.	3	R.	23W
------	----	------	---	----	-----

WELL NO.

#6 Calvin Lawson

FARM

COMPANY

Harry Gore

CONTRACTOR

 Empire Drlg.
 Norton Pool

Ft. from N. Line


330

Ft. from S. Line

Ft. from E. Line

1320

Ft. from W. Line

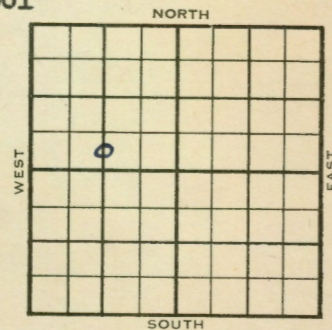C S $\frac{1}{2}$ S $\frac{1}{2}$ NW

1954

ELEVATION

2368'

REPORT

4/7

Spud 4-5-54

8" @ 257'

WOC.

4/11

WOC

5/12

Spud 4-5-54 Oil well TD 3692

8" @ 257' Anhy 1963 Heeb 3406

KC 3450 B KC 3627 Arb. 3687

TD 3690 5" @ 3688 DD 3692 9 BOPH

Comp. 167 BOPD

COMPLETED

County Norton State Kansas
 Sec. 30 (Blk.) 3 (Sur.) 23W Map No.
 Operator Harry Gore
 Well No. 6 Farm Calvin Lawson
 Elev. _____ Location C S $\frac{1}{2}$ S $\frac{1}{2}$ NW

330 Ft. From S Line NW
 1320 Ft. From W Line Quarter
 1st. Report APR 7 1954
 Completion _____
 Remarks Empire Drlg. - Contr.
 Spudding Date 4-5-54

Drlg. Data

8" @ 257 WOC

J. G. McGEHEE

County Norton State Kansas
 Sec. 30 (Blk.) 3 (Sur.) 23W Map No.
 Operator Harry Gore
 Well No. 6 Farm Calvin Lawson
 Elev. 2368 Location C S $\frac{1}{2}$ S $\frac{1}{2}$ NW

330 Ft. From S Line NW
 1320 Ft. From W Line Quarter
 1st. Report _____
 Completion MAY 12 1954
 Remarks Norton Pool
Empire Drlg. - Contr.
 Spudding Date 4-5-54

Drlg. Data

Oil well

TD 3692

8" @ 257 Anhy 1963 Heeb. 3406

KC 3450 B KC 3627 Arb. 3687 TD 3690

5" @ 3688 DD 3692 9 boph

Comp. 167 bopd

J. G. McGEHEE