
Norton KANSAS

DX 78-1

Section 30 Township 3 Range 23W

Well No. 1 Horning

Company Harry Gore

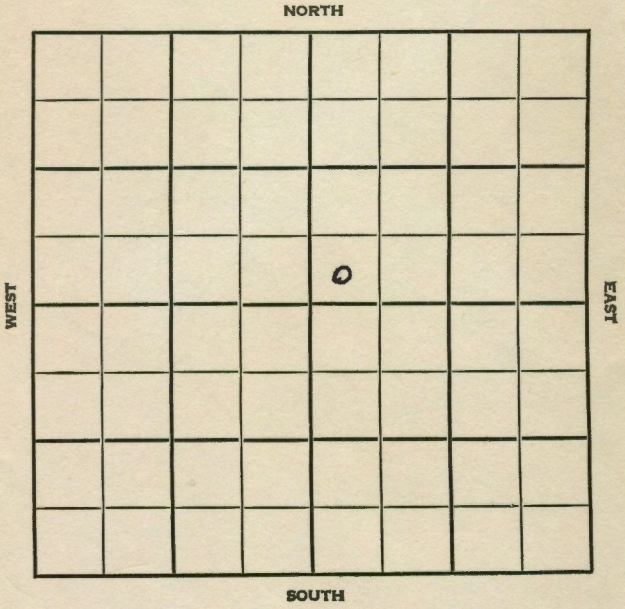

7

Norton KANSAS

SEC.	TWP.	R.
30	3	23W

WELL NO. 1 Horning FARM

COMPANY Harry Gore

CONTRACTOR Empire Drlg.

Norton Pool


_____ Ft. from N. Line

330 Ft. from S. Line

_____ Ft. from E. Line

330 Ft. from W. Line

SW SW NE

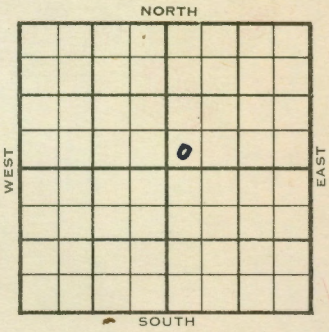

	ELEVATION 2402 REPORT
1954	
6/14	Location
6/23	"
6/30	8" @ 273' w/135 sks Drlg. 3600'
7/7	Heeb 3447', Tor 3474', Lans 3490', B KC 3669' DST 3726-33, 1½ hrs., 135' HOCM, 860# TD 3735' 5" @ 3729' Spudding 6-22-54
7/21	Oil well TD 3736 8" @ 273 Heeb 3447 Tor. 3474 Lans. 3490 BKC 3669 DST 3726-33 open 1½ hr. Rec. 135' hocm 860# TD 3735 Arb. 3729 5" @ 3729 DD 3736 Comp. 98 bopd

COMPLETED

DX-78

FORM 275 FOR SALE BY KANSAS BLUE PRINT CO.


County Norton State Kansas

Sec. 30 (Blk. Twp.) 3 (Sur. Rge.) 2 3W Map No.

Operator Harry Gore

Well No. 1 Farm Horning

Elev. 2402 Location SW SW NE

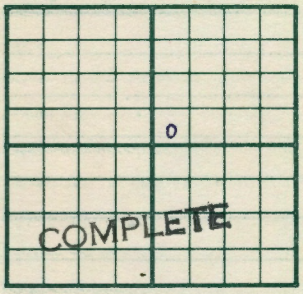

330 Ft. From S Line NE

330 Ft. From W Line Quarter

1st. Report

Completion JUL 21 1954

Remarks Norton Pool

Empire Drlg. - Contr.

Spudding Date 6-22-54

Drlg. Data Oil well TD 3736

8" @ 273 Heeb. 3447 Tor. 3474

Lans. 3490 B KC 3669 DST 3726-33

open 1½ hr. Rec. 135' hocm 860#

TD 3735 Arb. 3729 5" @ 3729 DD 3736

Comp. 98 bopd

J. G. McGEHEE

FORM 275 FOR SALE BY KANSAS BLUE PRINT CO.


County Norton State Kansas

Sec. 30 (Blk. Twp.) 3 (Sur. Rge.) 23W Map No.

Operator Harry Gore

Well No. 1 Farm Horning

Elev. Location SW SW NE

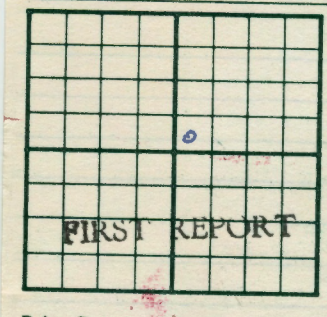

330 Ft. From S Line NE

330 Ft. From W Line Quarter

1st. Report JUN 15 1954

Completion

Remarks

Empire Drlg. - Contr.

Spudding Date

Drlg. Data Norton Pool

Location

J. G. McGEHEE