


NORTON

DX 78-1

KANSAS


Section 30 Township 3 Range 23W  
 Well No. #2 Horning  
 Company Harry Gore

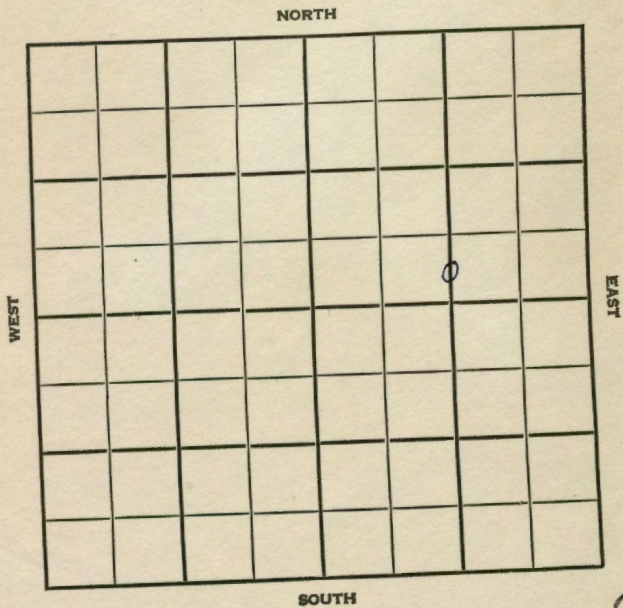

8

SEC. 30 TWP. 3 R. 23 W  
 WELL NO. # 2 Horning FARM  
 COMPANY  
 CONTRACTOR Harry Gore

H. Gore  
Norton Pool  
 \_\_\_\_\_ Ft. from N. Line  
330 \_\_\_\_\_ Ft. from S. Line  
1320 \_\_\_\_\_ Ft. from E. Line  
 \_\_\_\_\_ Ft. from W. Line  
 C S  $\frac{1}{2}$  S  $\frac{1}{2}$  NE

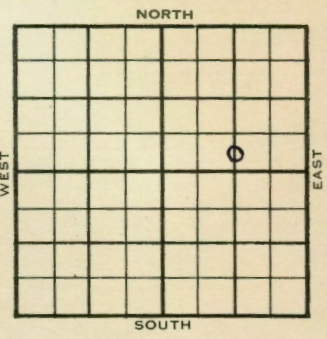

	ELEVATION	REPORT
1954	2444'	
9/8	Spud 9-6-54 8" @ 210 Drlg. 2033	Drlg. 2045'
10/6	Spud 9-6-54 - Oil Well TD 3772' 8" @ 210' Anhy 2043', Heeb 3489', Tor 3515', Lans 3531', B KC 3709', Arb. 3766' TD 3770' 5 " @ 3767' FU 175' oil 1 hr. DD 3772' P/140 BO 18 hrs. Comp. 139 bopd	

COMPLETED

DX-78

