DX 78-1

Section 30 Township 3 Range 23W

Well No. ~~9 Calvin Lawson~~

Company Harry Gore

NORTH

WEST EAST

SOUTH

3

Norton KANSAS

SEC.	TWP.	R.
30	3	23W

WELL NO. #9 Calvin Lawson

COMPANY FARM

Harry Gore

CONTRACTOR

Empire Drlg.

~~Norton Pool~~

1320 Ft. from N. Line

Ft. from S. Line

440 Ft. from E. Line

Ft. from W. Line

C E½ E½ NW

NORTH

WEST EAST

SOUTH

1954 ELEVATION 2379' REPORT

5/26 Spud 5-22-54
8" @ 263'
Anhy 1975'
Drlg 2530'

6/2 Heeb 3420 Tor 3450' Lans 3463'
B KC 3645' Gt. Wash 3706'
DST 3704-10, 3/4 hr, 330' oil, 920#
RTD 3710' 5" @ 3708

6/9 WOCT

6/23 Spud 5-22-54
Oil Well
TD 3710'
8" @ 263'
Anhy 1975', Heeb 3420', Tor 3450', Lans 3463', B KC 3645', Gr Wash 3706'
DST 3704-10', opn 3/4 hrs., rec. 330' oil, 920#
TD 3710'
5" @ 3708'
CO to 3710'
Comp. 112 bopd

COMPLETED

DX-78

FORM 275 FOR SALE BY KANSAS BLUE PRINT CO.

County Norton State Kansas

Sec. 30 (Blk. Twp.) 3 (Sur. Rge.) 23W Map No.

Operator Harry Gore

Well No. 9 Farm Calvin Lawson

Elev. 2379 Location C E½ E½ NW

1320 Ft. From N Line NW

440 Ft. From E Line Quarter

1st. Report

Completion JUN 23 1954

Remarks Norton Pool

Empire Drlg. - Contr.

Spudding Date 5-22-54

Drlg. Data Oil well TD 3710

8" @ 263 Anhy 1975 Heeb. 3420

Tor. 3450 Lans. 3463 B KC 3645

Gr. wash 3706 DST 3704-10 open 3/4 hr.

Rec. 330' oil 920# TD 3710 5" @ 3708

CO to 3710 Comp. 112 bopd

J. G. McGEHEE

FORM 275 FOR SALE BY KANSAS BLUE PRINT CO.

County Norton State Kansas

Sec. 30 (Blk. Twp.) 3 (Sur. Rge.) 23W Map No.

Operator Harry Gore

Well No. 9 Farm Calvin Lawson

Elev. Location C E½ E½ NW

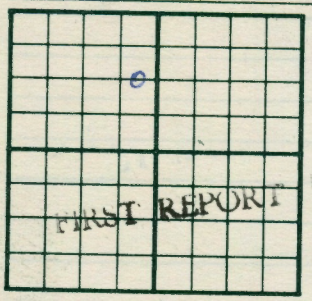

1320 Ft. From N Line NW

440 Ft. From E Line Quarter

MAY 26 1954

1st. Report

Completion

Remarks

Empire Drlg. - Contr.

Spudding Date 5-22-54

Drlg. Data Norton Pool

8" @ 263 Anhy 1975 drlg. 2530

J. G. McGEHEE