
FORM 51

Norton KANSAS

Section 30 Township 3 Range 23W

Well No. #1 Weber

Company D. G. Hansen

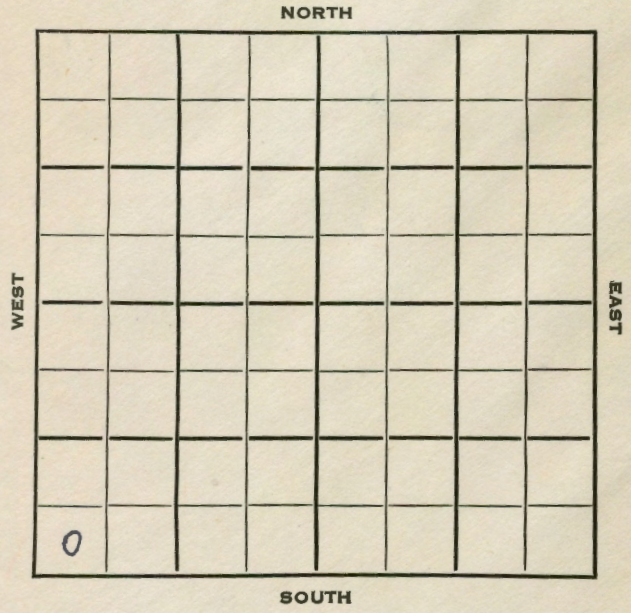

13

FORM 252-B

Norton KANSAS

Sec. 30 Twp. 3 R. 23W

Well No. #1 Weber Farm

D.G. Hansen Company

C & G Drlg. Contractor

Norton Pool

Ft. from N. Line


330 Ft. from S. Line

Ft. from E. Line

330 Ft. from W. Line

SW SW SW

J-S-F - DHM

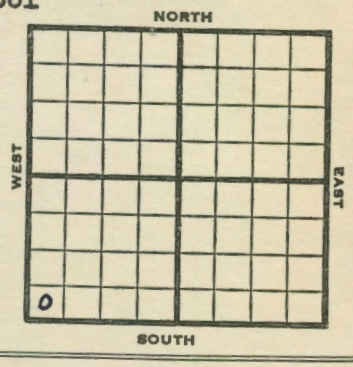

1953	Elev. 2405' REPORT
8/19	Spud 8-13-53 8" @ 287' Anhy 1994' Drlg 3120'
8/26	Heeb 3436, Tor 3461, Lans 3476, B KC 3663, Arb 3718 DST 3719-25, 1 hr, 400' gas, 380' gassy oil, 75' mco, 1180# RTD 3725 5" @ 3719'
9/2	CO 3725 FU 250' oil 2 hrs. S/ 58 BO 4½ hrs POP.
9/9	NR
9/16	"
9/23	"
9/30	"
10/7	"
10/14	Spud 8-13-53 Oil Well TD 3725' 8" @ 287' Anhy 1994', Heeb 3436', Tor 3461', Lans 3476, B KC 3663', Arb. 3718'

OVER

1953 (Information Brought Forward)
10/14 DST 3719-25, opn 1 hr., rec. 400'
gas, 380' gassy oil, 75' mco, 1180#
TD 3725
5" @ 3719
CO to 3725
FU 250' oil 2 hrs.
S/58 bo 4½ hrs.
Comp. 144 bopd

COMPLETED

FORM 275 FOR SALE BY KANSAS BLUE PRINT CO.

County Norton State Kansas

Sec. 30 (Blk. Twp.) 3 (Sur. Rge.) 23W Map No.

Operator D. G. Hansen

Well No. 1 Farm Weber

Elev. 2405 Location SW SW SW



330 Ft. From S Line SW

330 Ft. From W Line Quarter

1st. Report AUG 19 1953

Completion

Remarks J-S-F - DHM

C & G Drlg. - Contr.

Spudding Date 8-13-53

Drlg. Data Norton Pool

8" @ 287 Anhy 1994 drlg. 3120

J. G. McGEHEE

FORM 275 FOR SALE BY KANSAS BLUE PRINT CO.

County Norton State Kansas

Sec. 30 (Blk. Twp.) 3 (Sur. Rge.) 23W Map No.

Operator D. G. Hansen

Well No. 1 Farm Weber

Elev. 2405 Location SW SW SW



330 Ft. From S Line SW

330 Ft. From W Line Quarter

1st. Report

Completion OCT 14 1953

Remarks Norton Pool

C & G Drlg. - Contr.

Spudding Date 8-13-53

Drlg. Data Oil well TD 3725

8" @ 287 Anhy 1994 Heeb. 3436

Tor. 3461 Lans. 3476 B KC 3663

Arb. 3718 DST 3719-25 open 1 hr.

Rec. 400' gas 380' gassy oil 75' mco

1180# TD 3725 5" @ 3719 CO to 3725

FU 250' oil 2 hr. S/ 58 bo 4½ hr.

Comp. 144 bopd

J. G. McGEHEE