


Section 30 Township 3 Range 23W

Well No. 2 Weber

Company D. G. Hansen

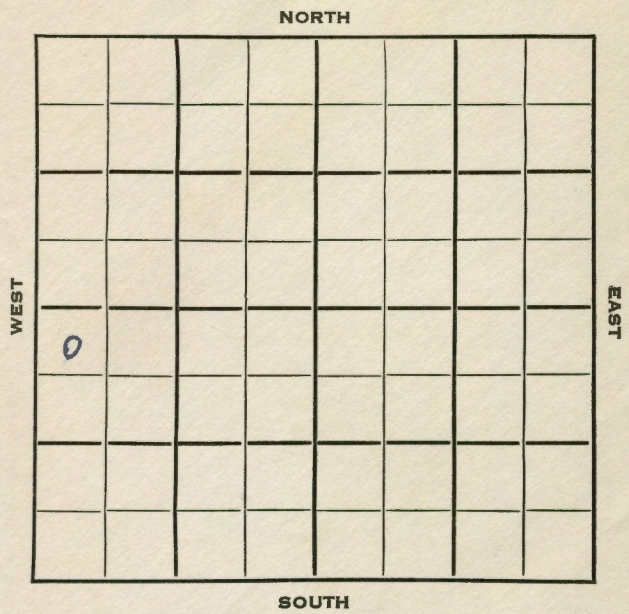

12

SEC. 30 TWP. 3 R. 23 W ✓
 WELL NO. # 2 Weber FARM
 COMPANY D. G. Hansen
 CONTRACTOR Cook & Gallaway

Norton Pool


330 Ft. from N. Line

_____ Ft. from S. Line

_____ Ft. from E. Line

330 Ft. from W. Line

NW NW SW

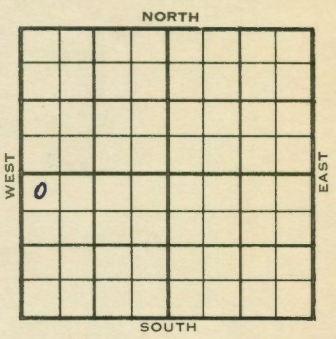

	ELEVATION	REPORT
1954	2350'	
2/17		Spud 2-15-54 8" @ 264 WOC
2/24		Anhy 1940' Heeb 3386 Tor 3411 Lans 3427 DST 3437-66, 1/2 hr, 18' M 230# B KC 3610 Regan 3668' RTD 3671' 5" @ 3668'
3/3		DD 3672' TD FU 2300' oil 14 hrs.
3/10		NR
4/14		"
4/21		Spud 2-15-54 Oil Well TD 3672' 8" @ 264' Anhy 1940', Heeb 3386', Tor 3411', Lans 3427' DST 3437-66', opn 1/2 hrs., rec. 18' mud 230# B KC 3610', Reagan 3668' TD 3671' 5" @ 3668' DD 3672' FU 2300' oil 12 hrs. Comp. 199 bopd

COMPLETED

