


KANSAS

Section 30 Township 3 Range 23WWell No. #1 WeberCompany D.G. Hansen

NORTH

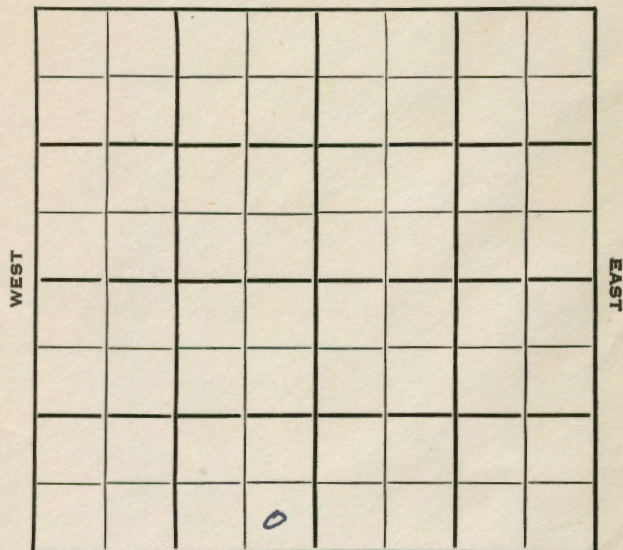

SOUTH

14

SEC.	TWP.	R.
30	3	23W ✓

WELL NO.

L Weber

COMPANY

FARM

D. G. Hansen

CONTRACTOR

C & G DRLG.

Norton Pool

Ft. from N. Line

440


Ft. from S. Line

440

Ft. from E. Line

Ft. from W. Line

NORTH

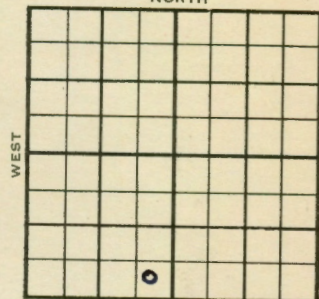

SOUTH

SE SE SW

J-S-F - DHM

1954

ELEVATION

2383'

REPORT

3/10

Spud 3-3-54
8" @ 240'Anhy 3249', Tor 3450',
Heeb 3424', KC 3465'

Drlg. 3610'

3/17

Arb. 3705' Reagan 3733'
RTD 3741' 5" @ 3741

3/24

WOCT

3/31

CO 3730 6/3707-09 FU 2100' oil
23 hrs. POP4/7
5/5

NR

Spud 3-3-54

Oil Well

TD 3741'

8" @ 240'

Anhy 3249', Tor 3450', Heeb 3424', KC
3465', Arb 3705' Reagan 3733'

TD 3741'

5" @ 3741'

CO to 3730 6/3707-09 FU 2100'
oil 23 hr.

Comp 182bopd.

COMPLETED

