


KANSAS

Section 30 Township 3 Range 23W

Well No. #8 Calvin Lawson

Company Harry Gore

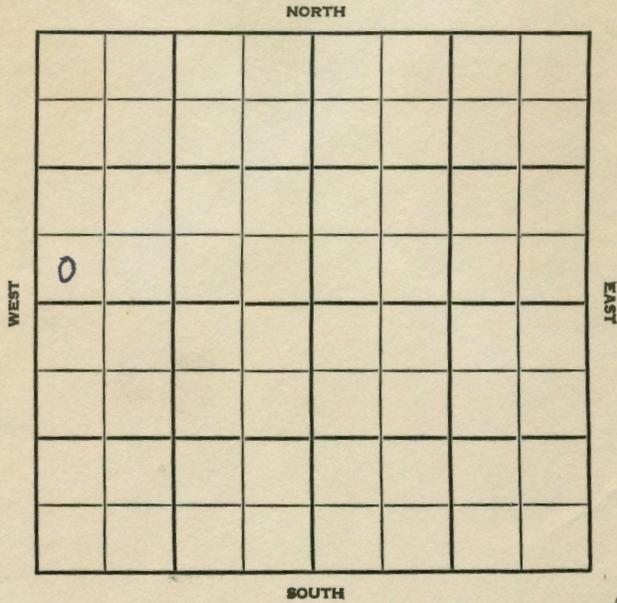


5

WELL NO. 30 3 23W

COMPANY #8 Calvin Lawson FARM

CONTRACTOR Harry Gore

Empire Drlg.  
Norton Pool

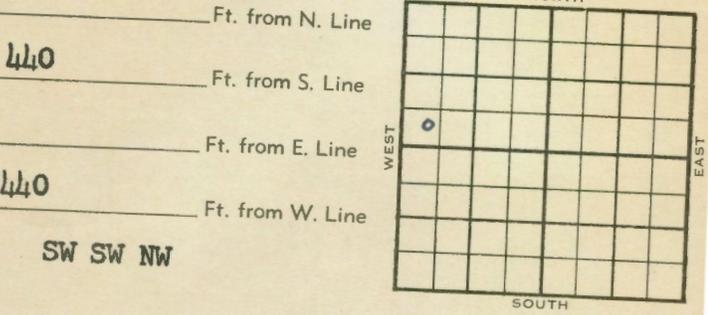

1954 ELEVATION 2343' REPORT

5/5 Spud ~~KX~~ 4-30-54 8" @ 273' Drlg 1315'

5/12 Spud ~~KX~~ 4-30-54 D & A TD 3710 8" @ 273' Heeb 3383 Tor. 3408 KC 3422 B KC 3602 Qtz. 3666 DST 3666-69 open 1 hr rec 12' mud 460# TD 3710' D & A

**ABANDONED**

