

Norton


KANSAS

24W

SECTION 6 TOWNSHIP 3 RANGE

WELL NO. #1 Collins

COMPANY Sauvage

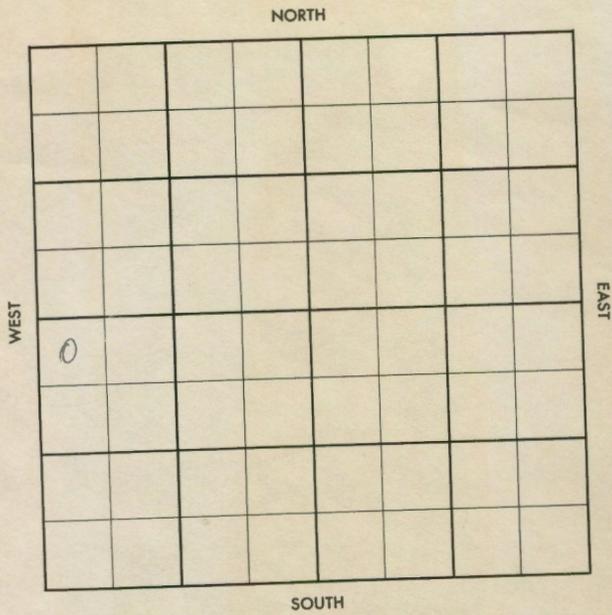

12

NOT FOR

SEC. 6 TWP. 3 R. 24W

WELL NO. #1 Collins FARM

COMPANY Sauvage

CONTRACTOR Co. Tools

WILDCAT


_____ Ft. from N. Line

_____ Ft. from S. Line

_____ Ft. from E. Line

_____ Ft. from W. Line

NW NW SW

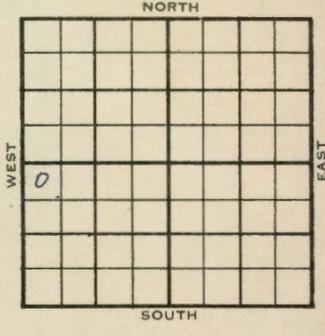

	ELEVATION	REPORT
1956	2465'	

4-18 Comm. 4-12-56
8" @ 141 w/115
Drlg. 1800

5-16 DST 3484-3517 op 30 min. rec. 5' VSOCM
BHP 140/20#
DST 3517-56 op 30 min. rec 40' mud,
BHP 100/20"
DST 3579-3630 op 1 hr. rec. 45' mud,
BHP 210/20"
D & A
H. 3399', Tr. 3424', L. 3439',
BKC 3630', G.W. 3721'
TD 3740'

ABANDONED

County Norton Elev. _____
 Sec. 6 Twp. 3 Rge. 21W
 Company Sauvage
 Farm Name Collins No. 1

TOPS	DEPTH	LOG	DATUM	Loc. in Sec.
Anh.				NW NW SW
T.P.				
H.				
Tr.				
Dg.				
Bl.				
L.				Geol. _____
K.C.				Contr. _____
B.K.C.				
Ce.				Co. tools
C.				
M.				Pool
M.				Wildcat
K.				
Mz.				
Me.				
V.				
S.				
S.				
A.				
R.				
Pf.				
G.				
T.D.				

FIRST REPORT
 APR 18 1956

Date Comm. 1-12-56
8" @ 141/115 drlg. 1800

APR 5 4 1956

R.G.

(Handwritten signature)