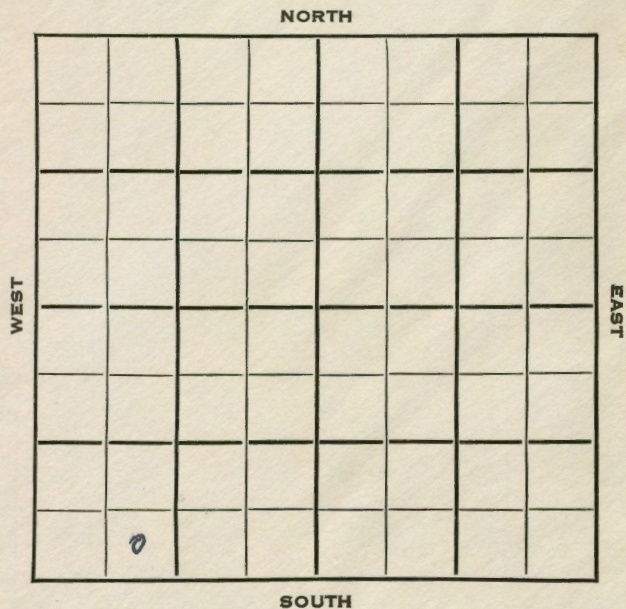


Section 6 Township 3 Range 24WWell No. 1 CollinsCompany Sauvage & Dunn

13

Sec. 6 Twp. 3 R. 24WWell No. #1 Collins FarmSauvage & Dunn CompanySauvage & Dunn Contractor

Wildcat.


Ft. from N. Line

330 Ft. from S. Line

Ft. from E. Line

990 Ft. from W. Line

SE SW SW

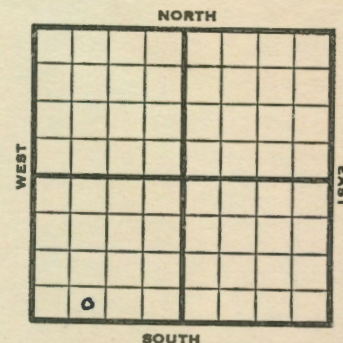

1953 Elev. - REPORT


8/19 Surface pipe set.

8/26 8" @ 220' w/125 sks
 Anhy 2013, Heeb 3400, Lans 3439
 DST 3443-57, 1 hr, 5' M, 540# 20"
 DST 3482'-3502' 1 hr, 15' fluid, 210#
 20" @ 3570'

9/2 Spud 8-17-53
 D&A
 TD 3786
 8" @ 220
 Anhy 2013, Heeb 3400, Lans 3459
 DST 3443-57, opn 1 hr., rec. 5' mud,
 540#
 DST 3482-3502, opn 1 hr., rec. 15'
 fluid, 210#
 B KC 3649, Gr. wash 3745
 TD 3786
 D&A

ABANDONED

County Norton State Kansas
 Sec. 6 (Blk. 3 (Sur. 24W Map No.
 (Twp.) (Rge.)
 Operator Sauvage & Dunne
 Well No. 1 Farm Collins
 Elev. Location SE SW SW

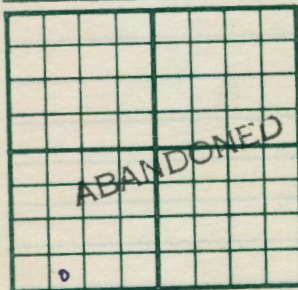


330 Ft. From S Line SW
990 Ft. From W Line Quarter
 1st. Report
 Completion SEP 2 1953
 Remarks Wildcat
Sauvage & Dunne - Contr.
 Spudding Date 8-17-53

Drig. Data D & A TD 3786
8" @ 220 Anhy 2013 Heeb. 3400
Lans. 3459 DST 3443-57 open 1 hr.
Rec. 5' mud 540# DST 3482-3502
open 1 hr. Rec. 15' fluid 210#
B KC 3649 Gr. wash 3745 TD 3786
D & A

J. G. McGEHEE

County Norton State Kansas
 Sec. 6 (Blk. 3 (Sur. 24W Map No.
 (Twp.) (Rge.)
 Operator Sauvage & Dunn
 Well No. 1 Farm Collins
 Elev. Location SE SW SW

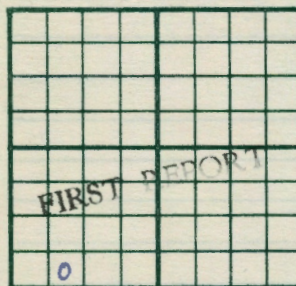

330 Ft. From S Line SW
990 Ft. From W Line Quarter
 1st. Report AUG 19 1953
 Completion
 Remarks
Sauvage & Dunn - Contr.
 Spudding Date

Drig. Data Wildcat
surface pipe set

J. G. McGEHEE