

Section 17 Township 3 Range 24 W

Well No. # 1 King


Company Trans-Era

SEC. 17 TWP. 3 R. 24 W ✓


WELL NO. # 1 King FARM

COMPANY Trans-Era

CONTRACTOR

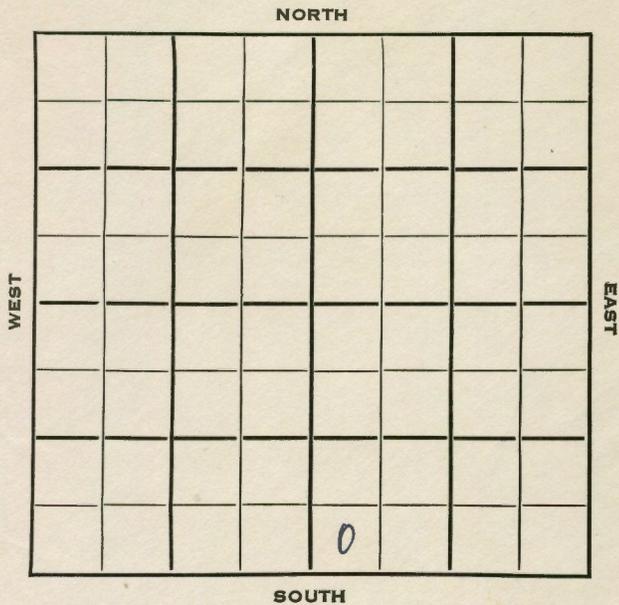

15

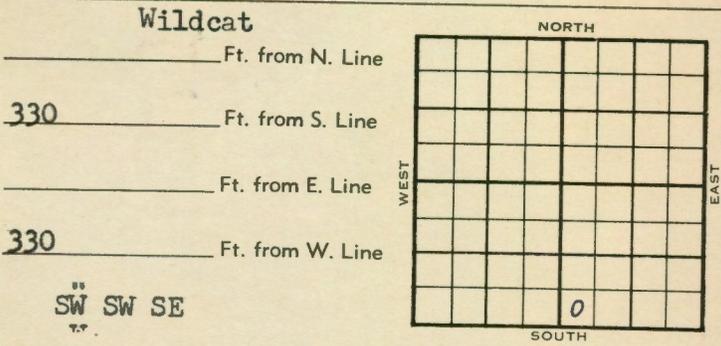

CSO - DHM

	ELEVATION	REPORT
1954	2400'	
2/3		Spud 1-30-54 8" @ 184 Drlg. 1917'
2/10		Heeb 3364', Lans 3406' DST 3452-95', 3/4 hrs., 10' OCM, 310# Drlg. 3650'
2/17		Spud 1-30-54 D & A TD 3675' 8" @ 184' Heeb 3364', Lans 3406', DST 3452'-95' opn 3/4 hr, rec 10' ocm 310# Gr. Wash 3663' TD 3675' DST 3633'-70' opn 3/4 hr, rec 6' Mud 50# D & A

ABANDONED

