


Section 23 Township 3 Range 24 W

Well No. # 1 Gooder

Company Jones, Shelburne & Farmer

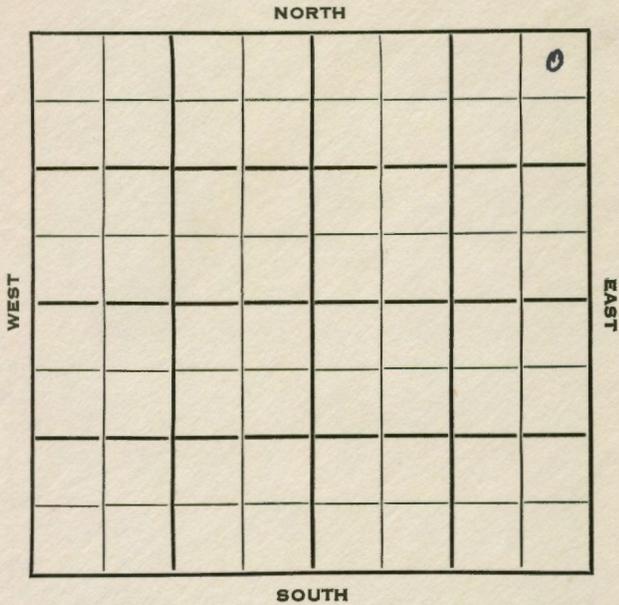

Norton KANSAS

SEC. <u>23</u>	TWP. <u>3</u>	R. <u>24W</u>
WELL NO. <u>#1 Gooder</u> FARM		
COMPANY <u>Jones, Shelburne & Farmer</u>		
CONTRACTOR <u>J-S-F Wildcat</u>		
<u>330</u> Ft. from N. Line		
_____ Ft. from S. Line		
<u>330</u> Ft. from E. Line		
_____ Ft. from W. Line		

NE NE NE
D/G. Hansen - support

	ELEVATION	REPORT
1953	2378'	
10/14	Location	
10/21	8" @ 280' Drlg. 3278'	
10/28	Spud 10-15-53 D&A TD 3720' 8" @ 280' Heeb 3384', Tor 3413', Lans 3426' DST 3459-77, opn 1/2 hrs., rec. 20' mud, 120# B KC 3612', Gr. wash 3674, Granite 3711' TD 3720' D&A	

ABANDONED

