

Norton

Section 25 Township 3 Range 24 W

Well No. # 6 Cora Fought

Company Woodriver Oil & Refg.

NORTON RANDOLPH

SEC. 25 TWP. 3 R. 24W

WELL NO. 6 Cora Fought FARM

COMPANY Woodriver O&R

CONTRACTOR Empire Drlg.

Norton Pool

Ft. from N. Line


330 Ft. from S. Line

990 Ft. from E. Line


Ft. from W. Line

SW SE SW

NORTH

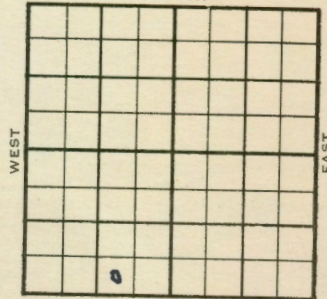

NORTH

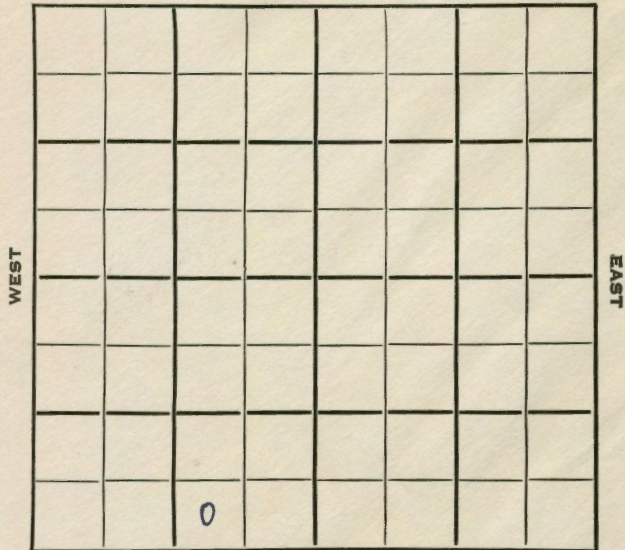

SOUTH

14

1954 ELEVATION 2407' REPORT

- 5/12 MIR
- 5/19 8" @ 261 w/135
Drlg. 3517'
- 5/26 **KC 3459' Arb. 3717'** RTD 3737
5" @ 3737
- 6/2 CO 3733' 12/3728-31 FU 1600' oil
7 hrs. S/50 BO 4 hrs. S/7 BOPH
POP
- 6/23 NR
- 6/30 NR
- 7/7 Spud 5-12-54 - Oil Well
TD 3737'
8" @ 261'
KC 3459', Arb. 3717'
TD 3737'
5" @ 3737'
CO to 3733'
12/3728-31', FU 1600' oil 7 hrs.
S/50 BO 4 hrs.
S/7 boph
Comp. 178 bopd

COMPLETED

