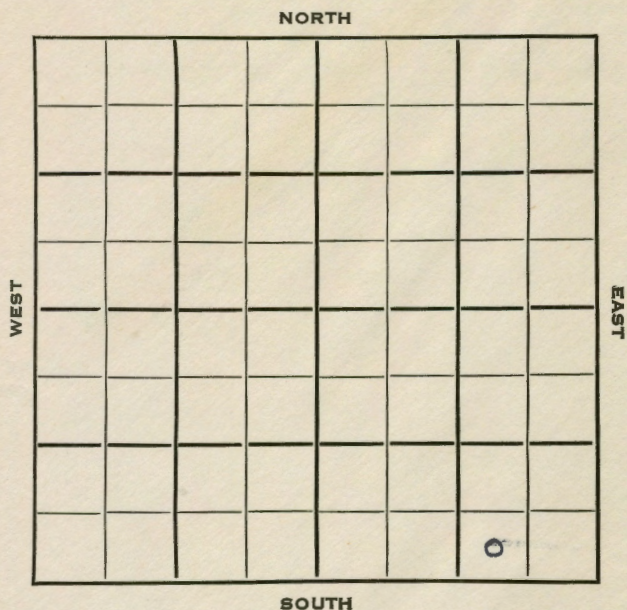


Section 25 Township 3 Range 24WWell No. #1 Colvin LawsonCompany Harry Gore

16

Sec. 25 Twp. 3 R. 24WWell No. #1 Colvin Lawson Farm

Harry Gore Company

Empire Drlg. Contractor

Norton Pool


Ft. from N. Line

330 Ft. from S. Line

990 Ft. from E. Line

Ft. from W. Line

SW SE SE

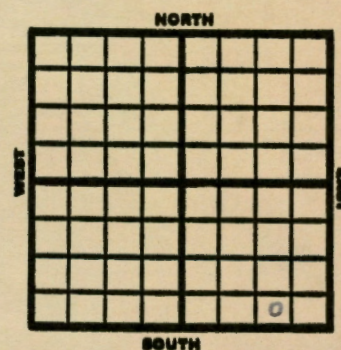

1953

Elev. 2407'

REPORT

9/2 Location
 9/9 8" @ 257' w/125 sks
 9/16 Heeb 3432' Tor 3456' Lans 3473'
 Drlg. 3602'
 9/23 B KC 3657', Arb. 3721'
 RTD 3724'
 5" @ 3722'
 DD 3725½
 P/7 boph + 3% wtr.
 9/30 M.R.
 10/7 P/5 BOPH 2% wtr.
 10/14 Spud 9-6-53
 Oil Well
 TD 3725
 8" @ 257'
 Heeb 3432', Tor 3456, Lans 3473',
 B KC 3657', Arb. 3721
 TD 3724
 5" @ 3722
 DD 3725, P/7 boph 3% wtr.
 P/5 boph 2% wtr.
 Comp. 162 bopd

COMPLETED

J. G. McGEHEE

J. G. McGEHEE