


Section 25 Township 3 Range 24 W

Well No. # 3 C. Lawson


Company Harry Gore

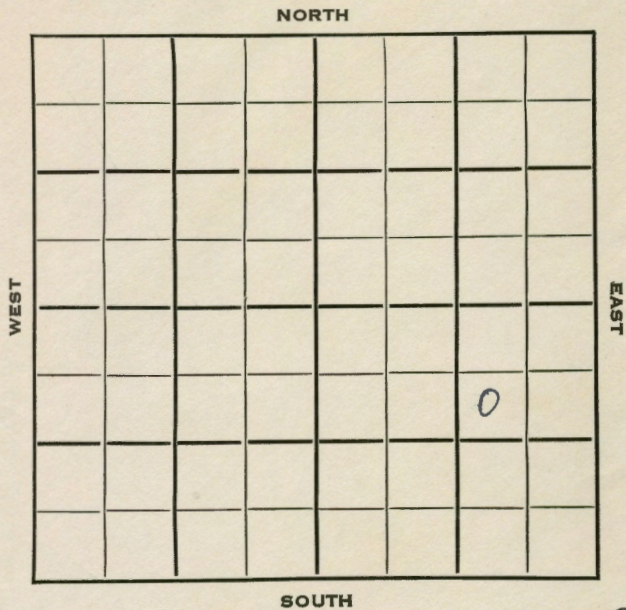

9

SEC. 25 TWP. 3 R. 24 W ✓
 WELL NO. # 3 C. Lawson FARM
 COMPANY # 3 C. Lawson
 CONTRACTOR Harry Gore

Empire Drlg.
 Norton Pool
 990 Ft. from N. Line
 Ft. from S. Line
 990 Ft. from E. Line
 Ft. from W. Line

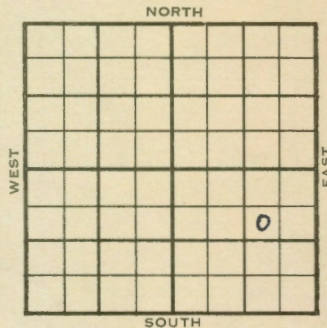

SW NE SE

	ELEVATION	REPORT
1953	2400'	
12/22	Location	
1954	8" @ 1985	Heeb 3435' Tor 3460'
1/6	KC 3474'	B KC 3658' Gorham 3720'
	Arb. 3722'	
	RTD 3726'	5" @ 3724'
1/13	CO 3726'	FU 2300' oil 12 hrs.
	POP P/83	BO 12 hrs.
1/20	NR	
2/10	NR	
2/24	Spud 12-24-53	
	Oil Well	
	TD 3726'	
	8" @ 249'	
	Anh6 1985'	Heeb 3435', Tor 3460,
	KC 3474',	B KC 3658', Gorham 3720',
	Arb. 3722'	
	TD 3726'	
	5" @ 3724'	
	CO to 3726,	FU 2300' oil 12 hrs.
	P/83	bo 12 hrs.
	P/5	boph
	Comp. 194	bopd

COMPLETED

County **Norton** State **Kansas**
 Sec. **25** (Blk. **3**) (Sur. **24W**) Map No.
 Operator **Harry Gore**
 Well No. **3** Farm **C. Lawson**
 Elev. **2400** Location **SW NE SE**

COMPLETE

990 Ft. From **N** Line **SE**
 990 Ft. From **E** Line **Quarter**
 Ist. Report
 Completion **FEB 24 1954**
 Remarks **Norton Pool**
Empire Drlg. - Contr.
 Spudding Date **12-24-53**

Drlg. Data **Oil well** **TD 3726**
8" @ 249 **Anhy 1985** **Heeb. 3435**
Tor. 3460 **KC 3474** **B KC 3658**
Gorham 3720 **Arb. 3722** **TD 3726**
5" @ 3724 **CO to 3726** **FU 2300' oil**
12 hr. P/ 83 bo **12 hr. P/ 5 bopd**
Comp. 194 bopd

J. G. McGEHEE

County **Norton** State **Kansas**
 Sec. **25** (Blk. **3**) (Sur. **24W**) Map No.
 Operator **Harry Gore**
 Well No. **3** Farm **C. Lawson**
 Elev. Location **SW NE SE**

FIRST REPORT

990 Ft. From **N** Line **SE**
 990 Ft. From **E** Line **Quarter**
 Ist. Report **DEC 22 1953**
 Completion
 Remarks
Empire Drlg. - Contr.
 Spudding Date

Drlg. Data **Norton Pool**

Location

J. G. McGEHEE