


Section 25 Township 3 Range 24W

Well No. #4 C. Lawson

Company Harry Gore

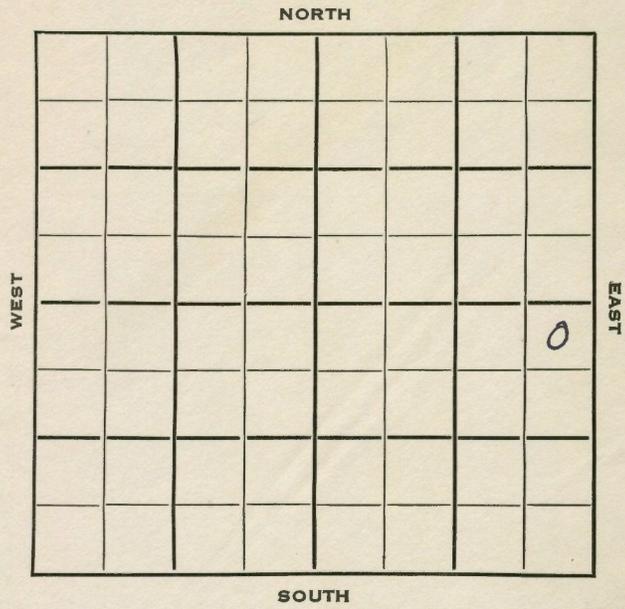

9

SEC. 25 TWP. 3 R. 24 W ✓

WELL NO. #4 C. Lawson FARM

COMPANY Harry Gore

CONTRACTOR Empire Drlg. Norton Pool


330 Ft. from N. Line

_____ Ft. from S. Line

330 Ft. from E. Line

_____ Ft. from W. Line

NE NE SE

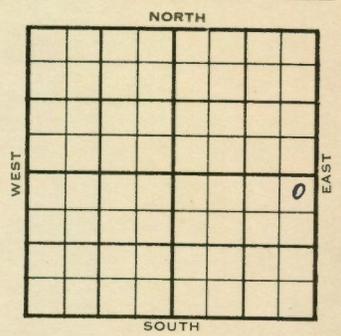

1954 ELEVATION 2362' REPORT

- 1/27 Spud 1-25-54
8" @ 231 WOC
- 2/3 Anhy 1954'
Drlg. 3545'
- 2/10 Heeb 3393', Tor 3420', L'ans 3435',
B KC 3623', Regan 3681'
RTD 3705'
5" @ 3705'
- 2/17 1/3683 24/3684-88 2 BWP^H + SO
FU 2000' fluid
- 2/24 Spud 1-25-54
Oil Well
TD 3705'
8" @ 231'
Anhy 1954', Heeb 3393', Tor 3420',
L'ans 3435', B KC 3623, Regan 3681'
TD 3705'
5" @ 3705'
1/3683, 24/3684-88, 2 bwph, SO
FU 2000' fluid, wtr. dec. to 3 gwph
Comp. 150 bopd

COMPLETED

