


Section 25 Township 3 Range 24W

Well No. 5 C. Lawson

Company Harry Gore

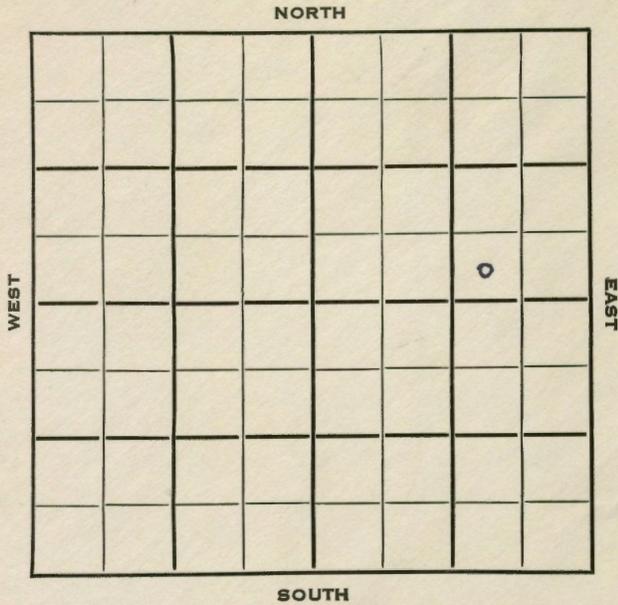

8

SEC. 25 TWP. 3 R. 24 W ✓  
 WELL NO. 5 C. Lawson FARM  
 COMPANY Harry Gore  
 CONTRACTOR Harry Gore

Empire Drlg.  
Norton Pool  
 \_\_\_\_\_ Ft. from N. Line  
330 \_\_\_\_\_ Ft. from S. Line  
990 \_\_\_\_\_ Ft. from E. Line  
 \_\_\_\_\_ Ft. from W. Line

SW SE NE

	ELEVATION	REPORT
1954	2394'	
2/17	Spud 2-14-54 8" @ 256 Drlg. 1480'	
2/24	Anhy 1983' Heeb 3429 Tor 3459 Lans 3468 B KC 3655 Reagan 3712 RTD 3716 5" @ 3715	
3/3	WOCT	
3/10	B & A	
3/24	Spud 2-14-54 D&A TD 3740' 8" @ 256' Anhy 1983', Heeb 3429', Tor 3459', Lans 3468', B KC 3655', Regan 3712' TD 3716' 5" @ 3715' DD 3717' HFW Granite 3740' TD 3740' 2 go 2 gwph 4/3713-16 4 go 1 gwph D&A	

ABANDONED

