


Section 26 Township 3 Range 24 W
Well No. # 1 Manley Davis
Company Empire Drlg.

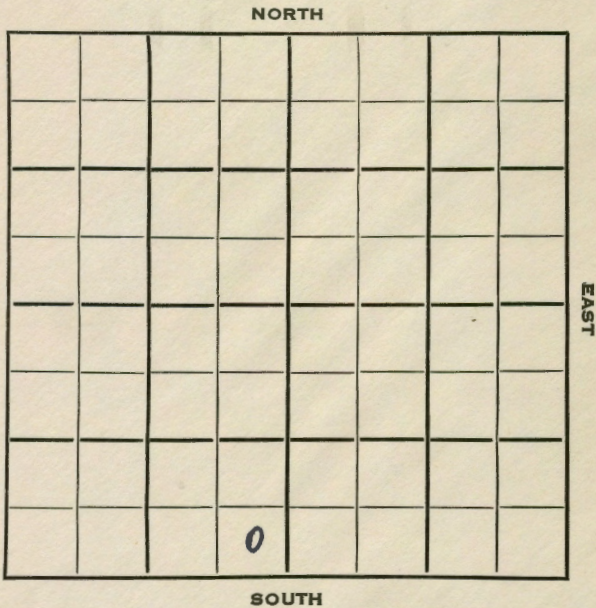


14

Sec. 26 Twp. 3 R. 24 W
Well No. #1 Manley Davis Farm
Empire Drlg. Company
Empire Drlg. Contractor
Wildcat

_____ Ft. from N. Line
330 Ft. from S. Line
330 Ft. from E. Line
_____ Ft. from W. Line

SE SE SW

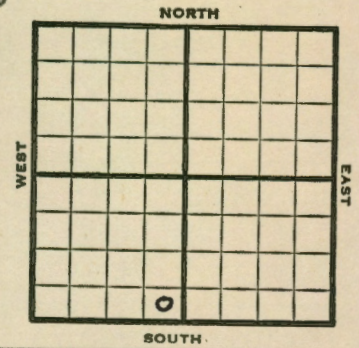

1953

Elev. 2421' REPORT

6/10
6/24

M I R
Spud 6-11-53
D & A TD 3820' 8" @ 186
Anhy 2000 Top. 3305' Heeb 3442
Tor. 3468 Lans 3484 B KC 3668
Marm 3715 PreCamb 3768
TD 3820' D & A

ABANDONED

County Norton State KANSAS
 Sec. 26 (Blk. 3 (Sur. 24W Map No. 3)
 Operator Empire Drlg.
 Well No. 1 Farm Manley Davis
 Elev. 2421 Location SE SE SW

ABANDONED

330 Ft. From S Line SW
 330 Ft. From E Line Quarter
 Ist. Report _____
 Completion JUN 24 1953
 Remarks Wildcat
Empire Drlg. - Contr.
 Spudding Date 6-11-53

Drlg. Data D & A TD 3820
8" @ 186 Anhy 2000 Top. 3305
Heeb. 3442 Tor. 3468 Lans. 3484
B KC 3668 Marm. 3715 PreCamb. 3768
TD 3820
D & A

J. G. MCGEHEE

County Norton State KANSAS
 Sec. 26 (Blk. 3 (Sur. 24W Map No. 3)
 Operator Empire Drlg.
 Well No. 1 Farm Manley Davis
 Elev. _____ Location SE SE SW

FIRST REPORT

330 Ft. From S Line SW
 330 Ft. From E Line Quarter
 Ist. Report JUN 10 1953
 Completion _____
 Remarks _____
Empire Drlg. - Contr.
 Spudding Date _____

Drlg. Data _____ Wildcat
M I R

J. G. MCGEHEE