


Section 27 Township 3 Range 24W

Well No. #1 Brown

Company Jones, Shelburne & Farmer

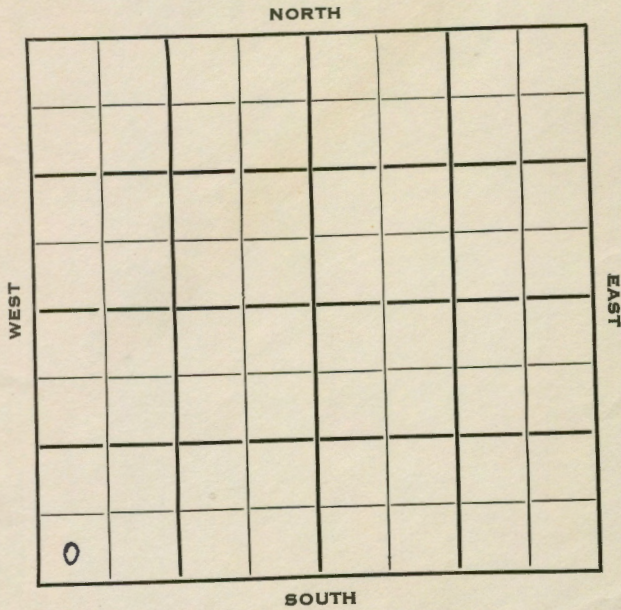

13

SEC. <u>27</u>	TWP. <u>Norton</u>	R. <u>24 W</u>
----------------	--------------------	----------------

WELL NO. # 1 Brown FARM

COMPANY Jones, Shelburne & Farmer

CONTRACTOR J-S-F

J-S-F

Wildcat


_____ Ft. from N. Line

330 _____ Ft. from S. Line

_____ Ft. from E. Line

330 _____ Ft. from W. Line

SW SW SW

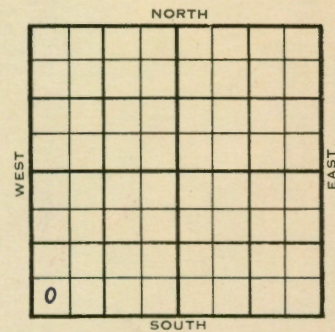

CSO - DHM

	ELEVATION	REPORT
1954	<u>2451'</u>	

1/27 Spud 1-23-54
8" @ 280
Drlg. 1850'

2/3 Spud 1-23-54 D & A TD 3794'
8" @ 280 Anhy 2016 Heeb 3449
Tor. 3477 Lans 3489'
DST 3537-67 open 1/2 hr rec 10' mud
380# B KC 3669 Gr Wash 3760
Gr. 3788
TD 3794'
DST 3758-65, open 1/2 hr, rec 4' mud
D & A

ABANDONED

County Norton State Kansas
 Sec. 27 (Blk. 3 (Sur. 24W Map No.
 Operator Jones, Shelburne & Farmer
 Well No. 1 Farm Brown
 Elev. 2451 Location SW SW SW

ABANDONED

330 Ft. From S Line SW
330 Ft. From W Line Quarter
 Ist. Report
 Completion FEB 3 1954
 Remarks Wildcat
J-S-F - Contr.
 Spudding Date 1-23-54

Drlg. Data D & A TD 3794
8" @ 280 Anhy 2016 Heeb. 3449
Tor. 3477 Lans. 3489 DST 3537-67
open 1/2 hr. Rec. 10' mud 380#
B KC 3669 Gr. wash 3760 Gr. 3788
TD 3794 DST 3758-65 open 1/2 hr.
Rec. 4' mud

D & A

J. G. McGEHEE

County Norton State Kansas
 Sec. 27 (Blk. 3 (Sur. 24W Map No.
 Operator Jones, Shelburne & Farmer
 Well No. 1 Farm Brown
 Elev. 2451 Location SW SW SW

FIRST REPORT

330 Ft. From S Line SW
330 Ft. From W Line Quarter
 Ist. Report JAN 27 1954
 Completion
 Remarks CSO - DHM
J-S-F - Contr.
 Spudding Date 1-23-54

Drlg. Data Wildcat
8" @ 280 drlg. 1850

J. G. McGEHEE