


Section 29 Township 3 Range 2W

Well No. #1 Ankeman

Company Jones, Shelburne & Farmer

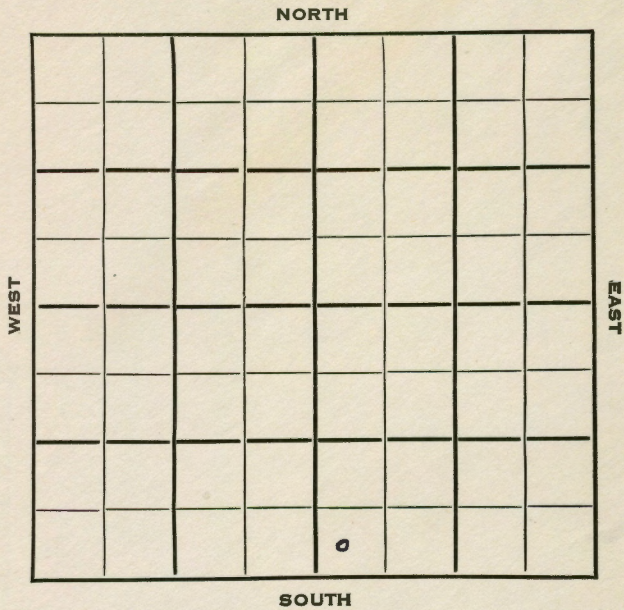


Norton KANSAS

SEC. 29 TWP. 3 R. 2W

WELL NO. #1 Ankeman FARM

COMPANY Jones, Shelburne & Farmer

CONTRACTOR

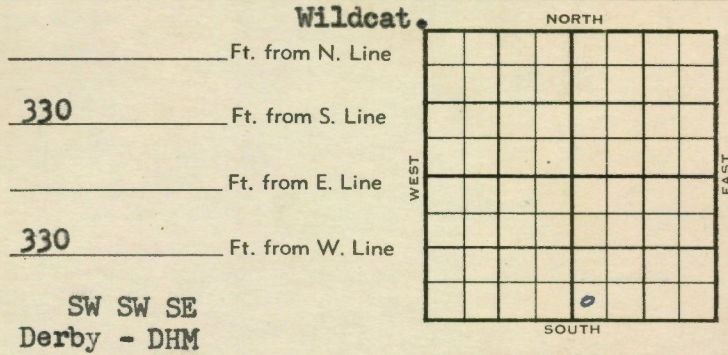

	ELEVATION	REPORT
1954	2399'	
3/31	Location	
4/7	8" @ 280 w/125	
	Anhy 1967'	
	Drlg. 2485'	
4/14	Spud 4-3-54	
	D & A	
	TD 3811'	
	8" @ 280'	
	Anhy 1967', Heeb 3395', Lans 3438',	
	B KC 3619', Reagan 3715',	
	DST 3706' -10' opn 1/2 hr, rec 13' ocm	
	200#	
	DST 3718' -26' opn 1/2 hr, rec 1230' sw	
	1150# Grn Wash 3747', Gr. 3789'	
	TD 3811'	
	D & A	

**ABANDONED**

