



Section 30 Township 3 Range 24 W
 Well No. # 1 Clark
 Company Trans-Era Pet.

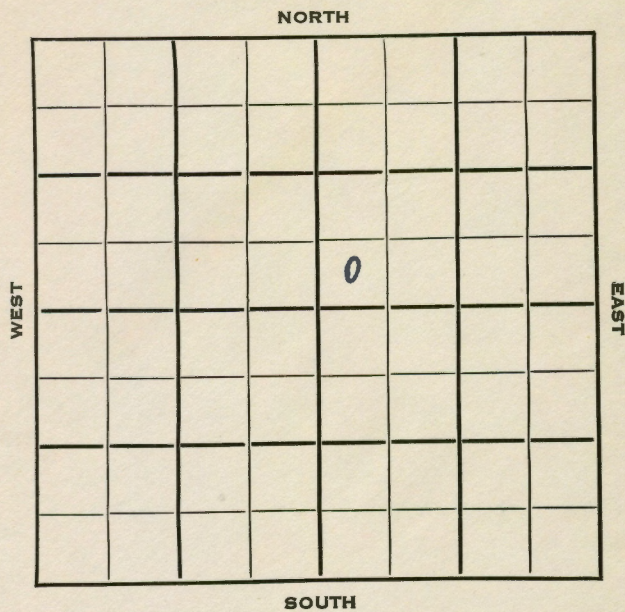

SEC. 30 TWP. 3 R. 24W
 WELL NO. #1 Clark FARM
 COMPANY Trans-Era Pet.
 CONTRACTOR Trans Era

Wildcat.
 _____ Ft. from N. Line
330 _____ Ft. from S. Line
 _____ Ft. from E. Line
330 _____ Ft. from W. Line

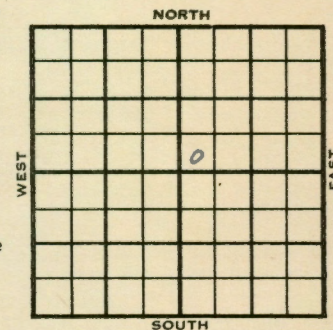

SW SW NE
 Phillips & CSO support
 Shell - DHM

	ELEVATION	REPORT
1953	2418'	
10/21	Spud 10-16-53 8" @ 176' Anhy 1980' Drlg 2865'	
10/28	Spud 10-16-53 D&A TD 3830' 8" @ 176' Anhy 1980', Top 3262', Heeb 3403', Tor 3428', Lans 3445', B KC 3631', Arb. 3741', Regan 3776', Gr wash 3783', ~~EXP~~ Pre Camb. 3816' TD 3830' D&A	

ABANDONED

County Norton State Kansas
 Sec. 30 (Bk. 3 (Sur. 24W Map No.
 Operator Trans-Era Pet.
 Well No. 1 Farm Clark
 Elev. 2418 Location SW SW NE
 330 Ft. From S Line NE
 330 Ft. From W Line Quarter
 1st. Report
 Completion OCT 28 1953
 Remarks Wildcat
Trans-Era - Contr.
 Spudding Date 10-16-53
 Drilg. Data D & A TD 3830

8" @ 176 Anhy 1980 Top. 3262
 Heeb. 3403 Tor. 3428 Lans. 3445
 B KC 3631 Arb. 3751 Regan 3776
 Gr. wash 3783 PreCamb. 3816 TD 3830
D & A

J. G. McGEHEE

County Norton State Kansas
 Sec. 30 (Bk. 3 (Sur. 24W Map No.
 Operator Trans-Era Pet.
 Well No. 1 Farm Clark
 Elev. Location SW SW NE
 330 Ft. From S Line NE
 330 Ft. From W Line Quart
 1st. Report OCT 21 1953
 Completion Phillips & GSO
 Remarks Shell - BHM supp
Trans-Era - Contr.
 Spudding Date 10-16-53
 Drilg. Data Wildcat

8" @ 176 Anhy 1980 drlg. 2865

J. G. McGEHEE